


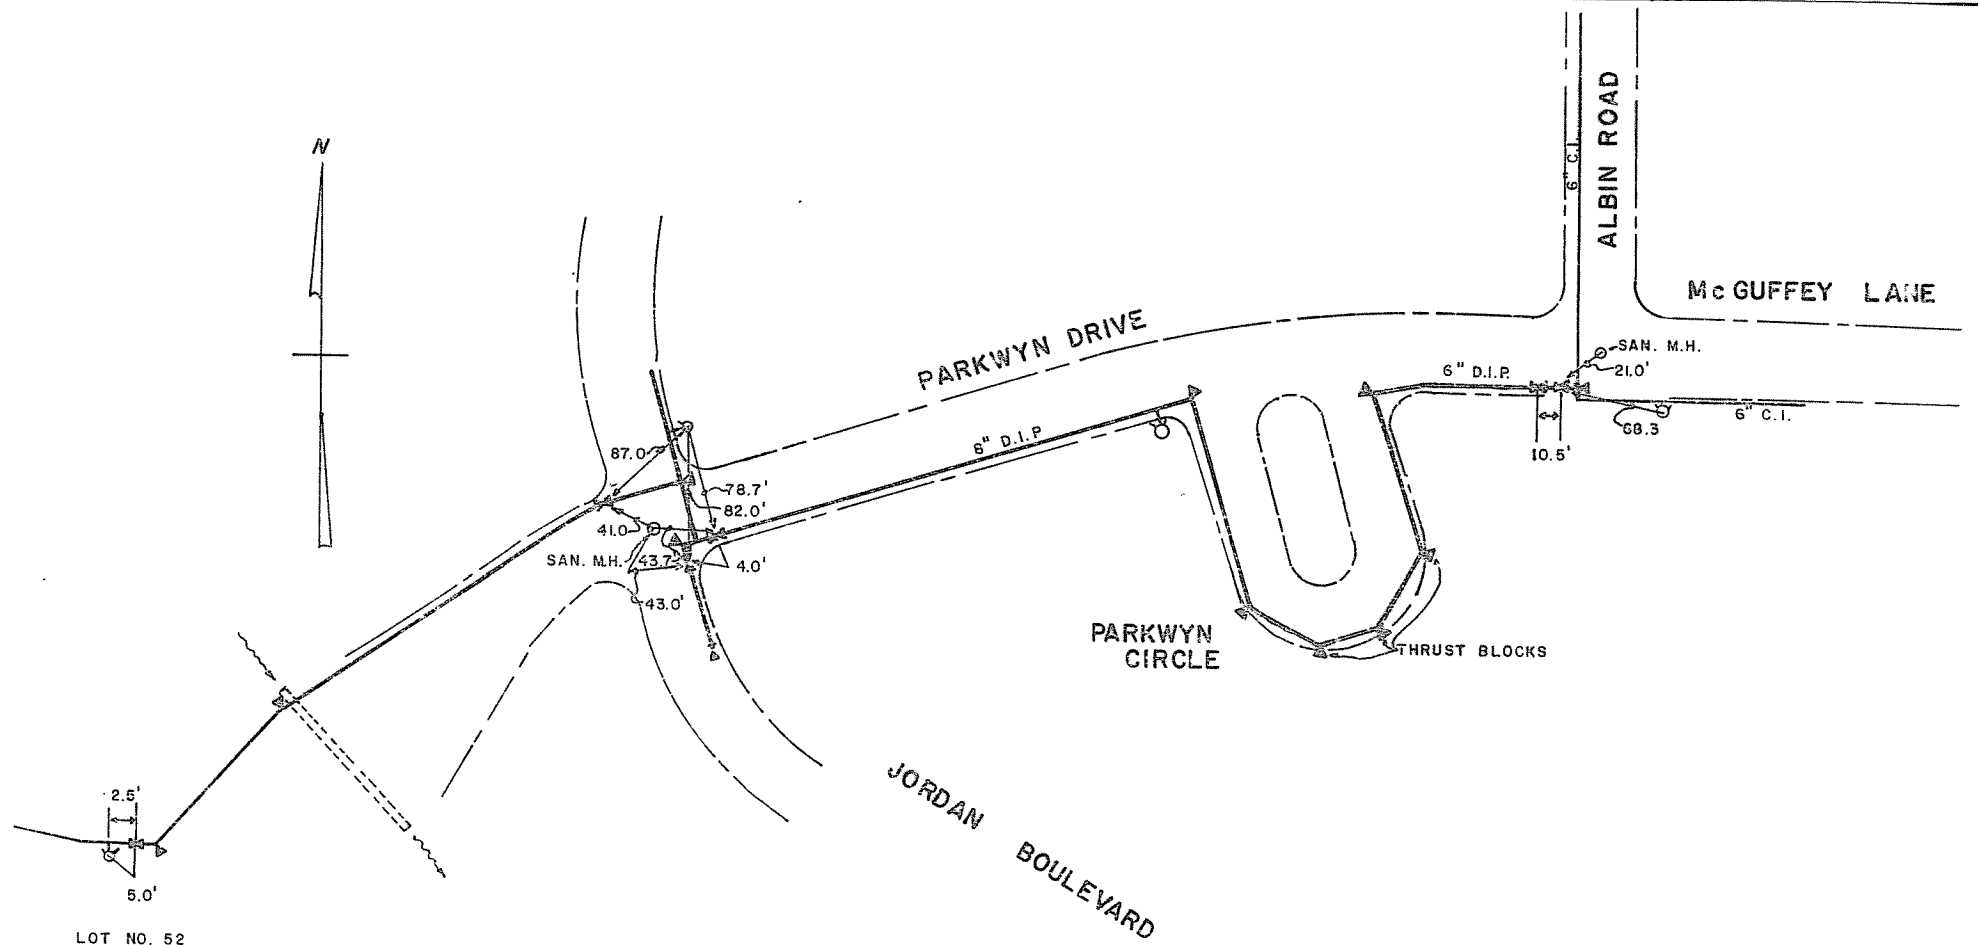

PARKWYN DRIVE

WATER DISTRICT NO. 1
TOWN OF BETHLEHEM

RECORD OF INSTALLATIONS
J. KENNETH FRASER & ASSOCIATES, P.C.
CONSULTING ENGRS. RENSSELAER, N.Y.
SCALE 1"=50' AUGUST 1979

Dwn. by H.P.J.
Chk. by W.T.B.