


PARKWYN DRIVE

SCALE
1" = 50'
REB

TOWN OF BETHLEHEM
ENGINEERING DEPARTMENT
9-1 DELAWARE AVE. BETHLEHEM, PA 18010

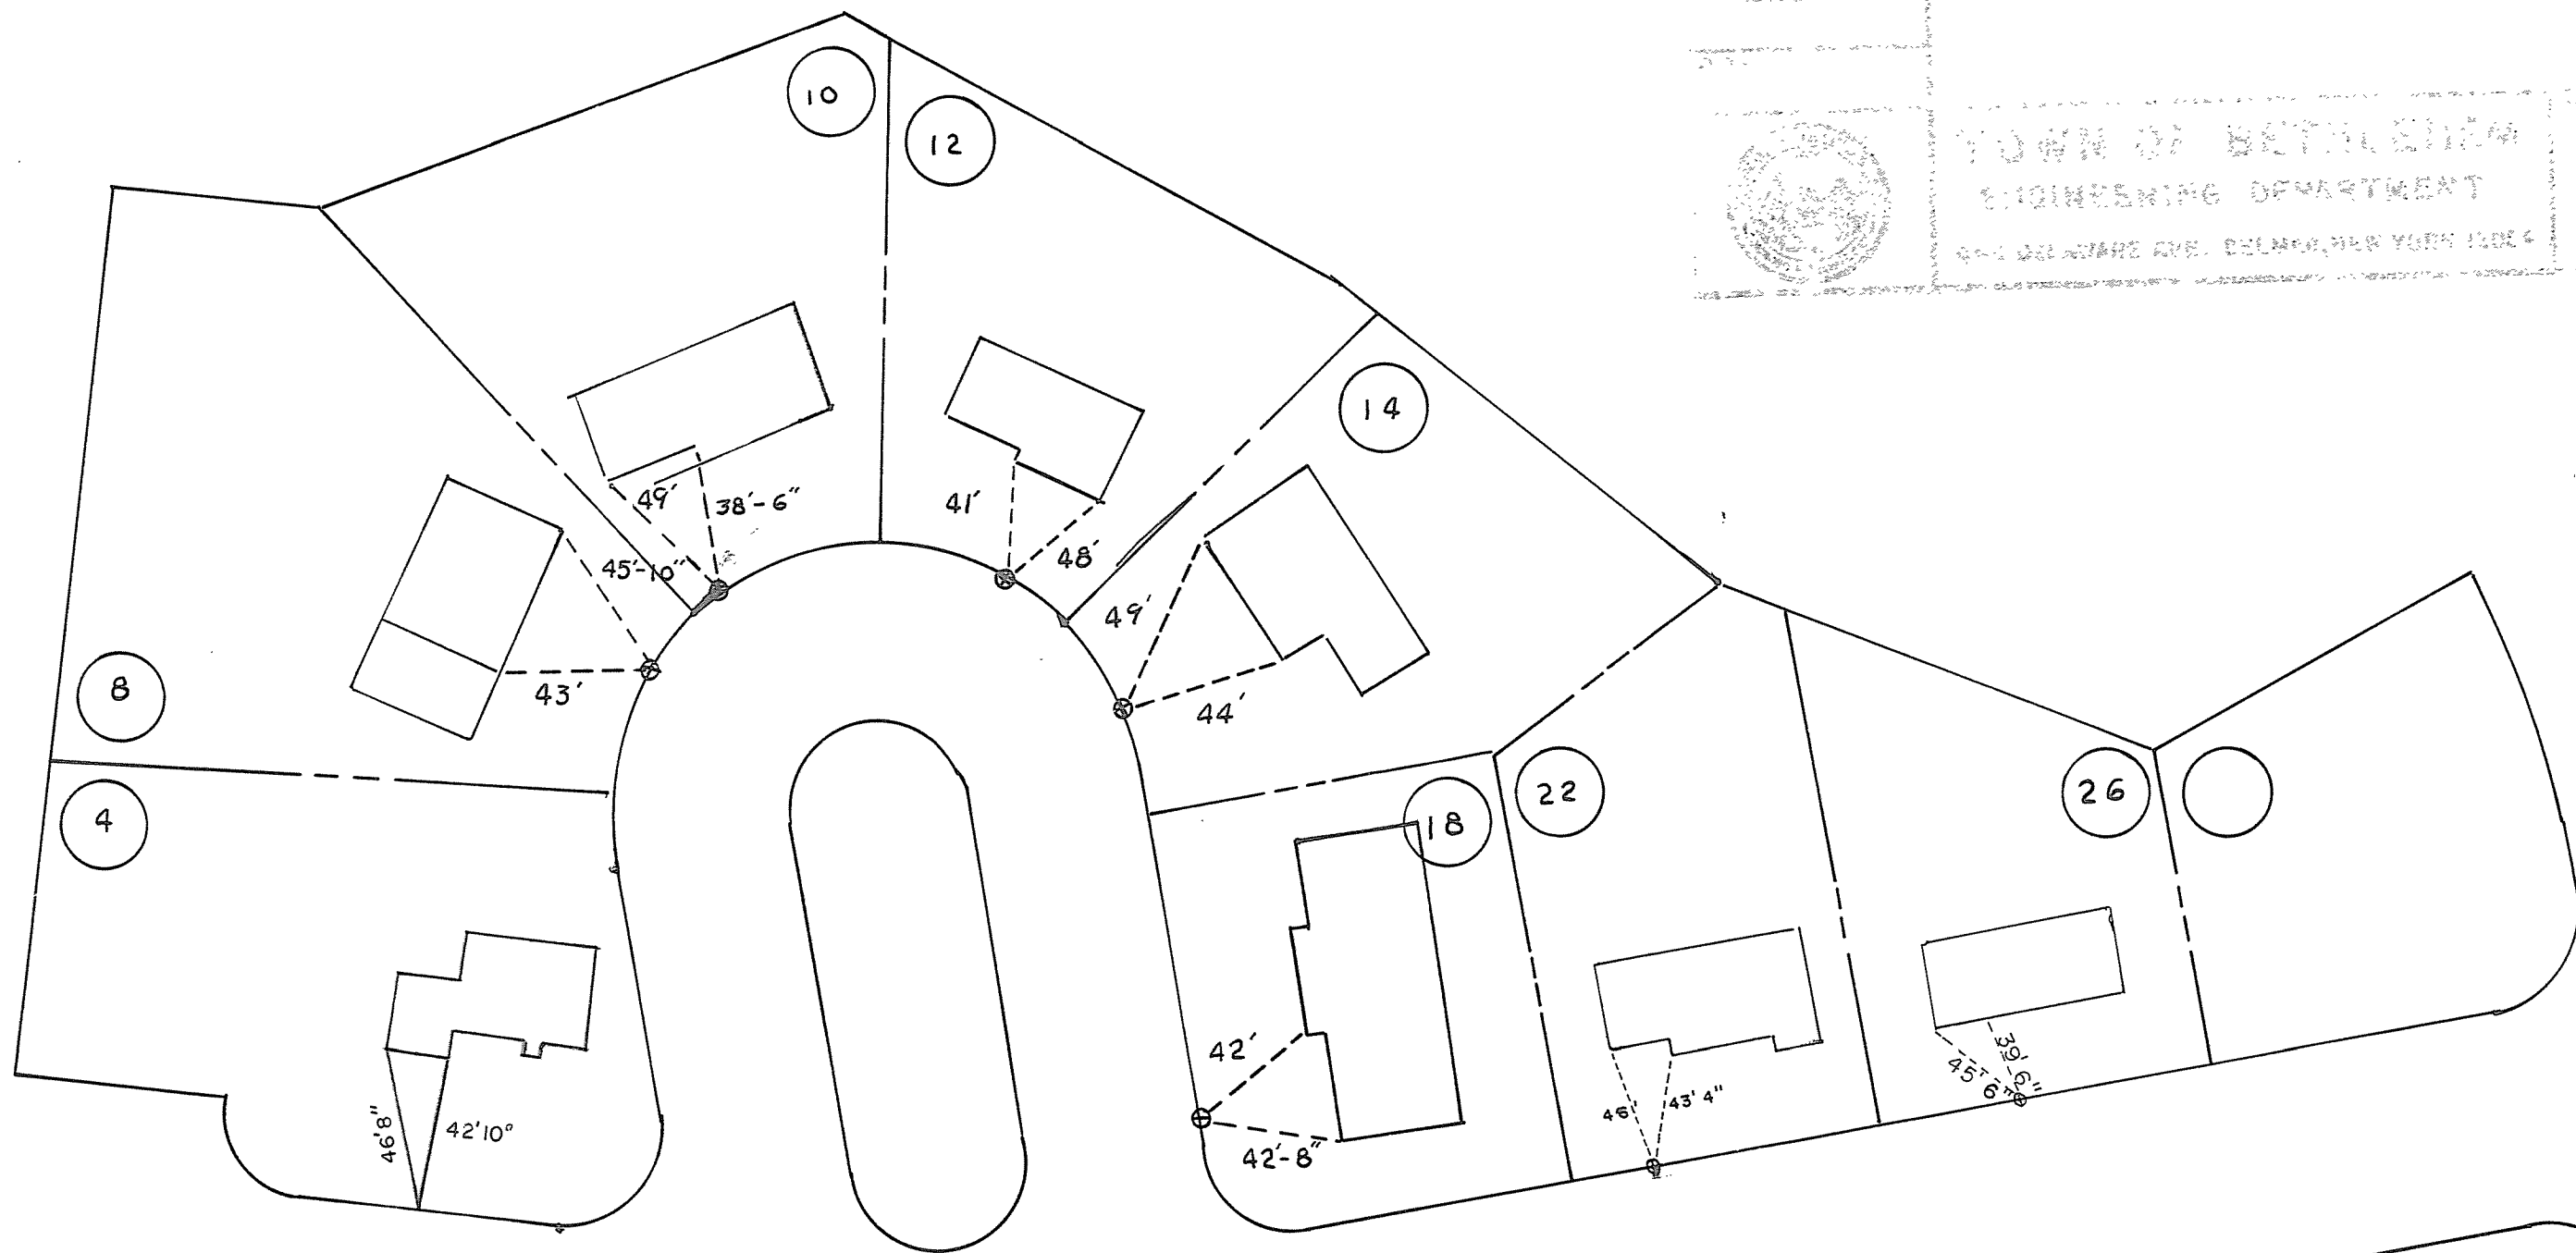

PARKWYN

DRIVE