


PHEASANT LANE

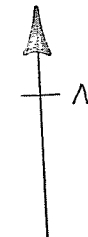

Street Sign
Hyd.

PARKWYN

DRIVE

8" Ductile Iron
Water Main

Hyd.

6' Typical

Hyd.

Scale: 1"=60'

Legend

- Water Main
- Sanitary Sewer
- Storm Sewer
- Property Line
- x— Water Valves & Hyd.

PARKWYN DRIVE
WATER DISTRICT NO. 1
TOWN OF BETHLEHEM
RECORD OF INSTALLATIONS
J. KENNETH FRASER & ASSOCIATES, P.C.
CONSULTING ENGRS. RENSSELAER, N.Y.
SCALE AS SHOWN OCTOBER, 1976