


BLVD

JORDAN

PARKWYN

DRIVE

PARKWYN DRIVE

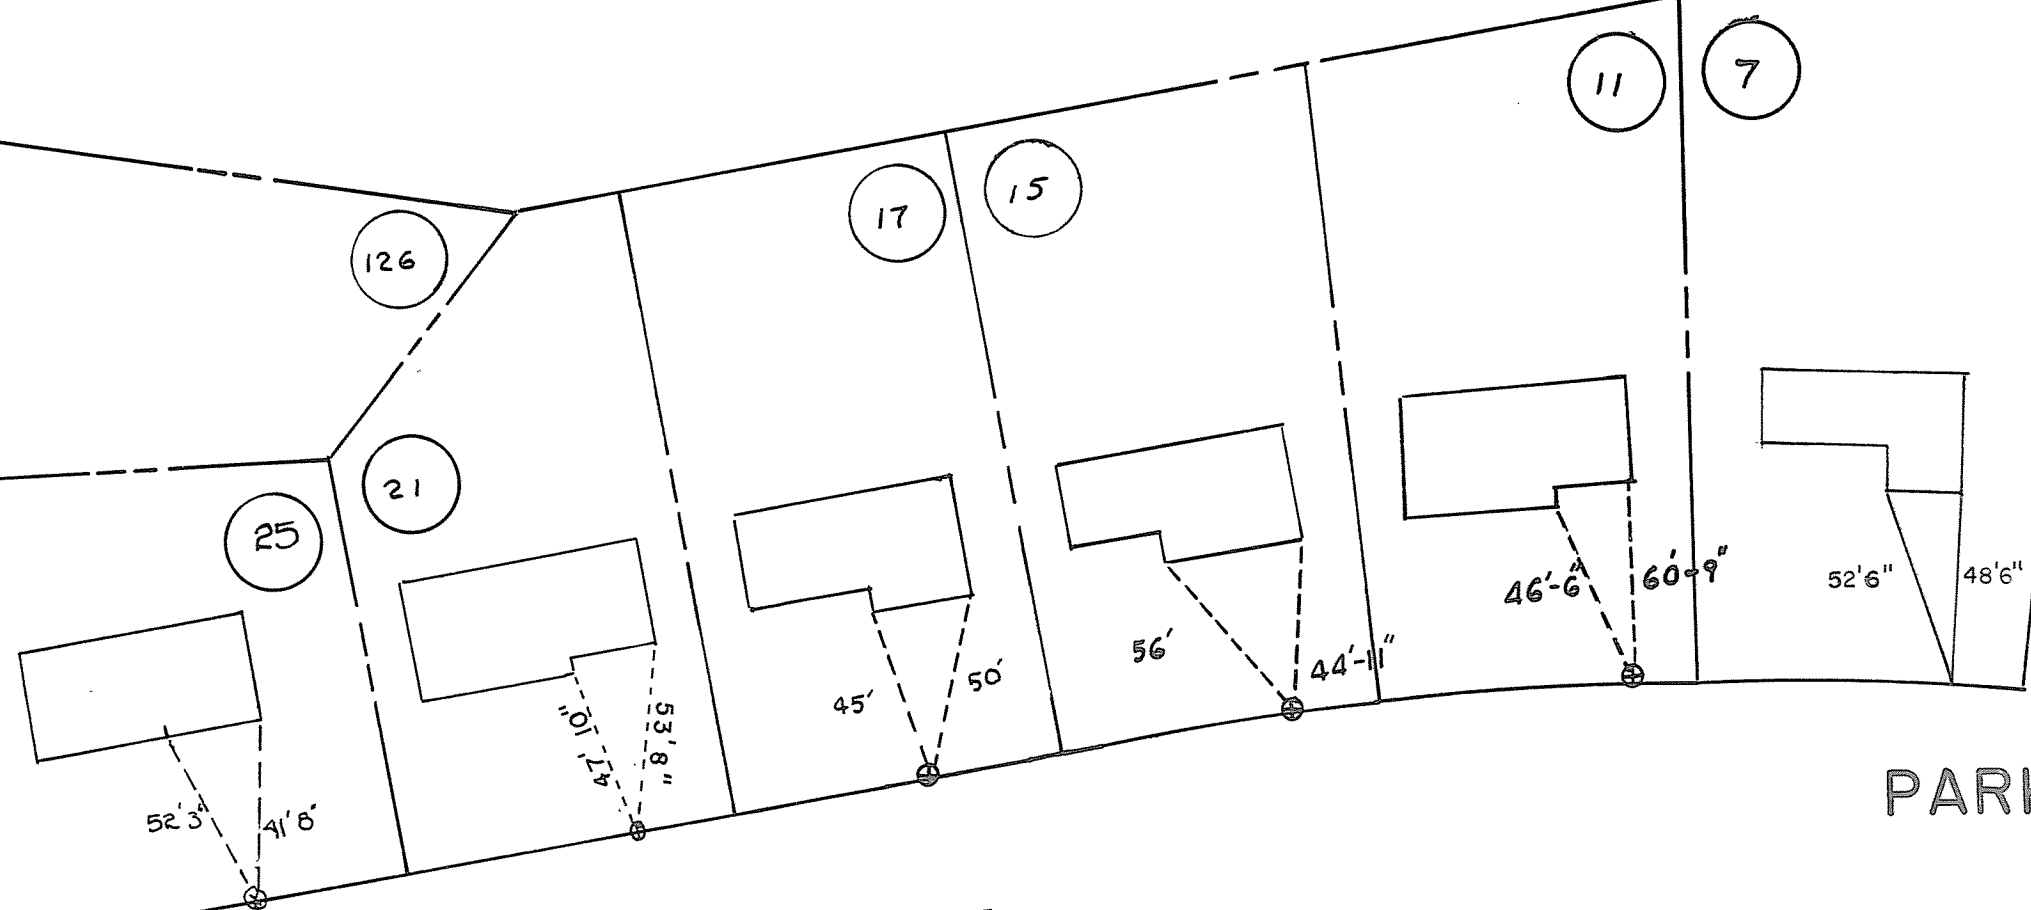

SCALE
1" = 50'
DRAWN BY
R E B
APPROVED

DATE



TOWN OF BRIMLEY
ENGINEERING DEPARTMENT
400 BRIMLEY AVE. BRIMLEY, NEW YORK 12552