



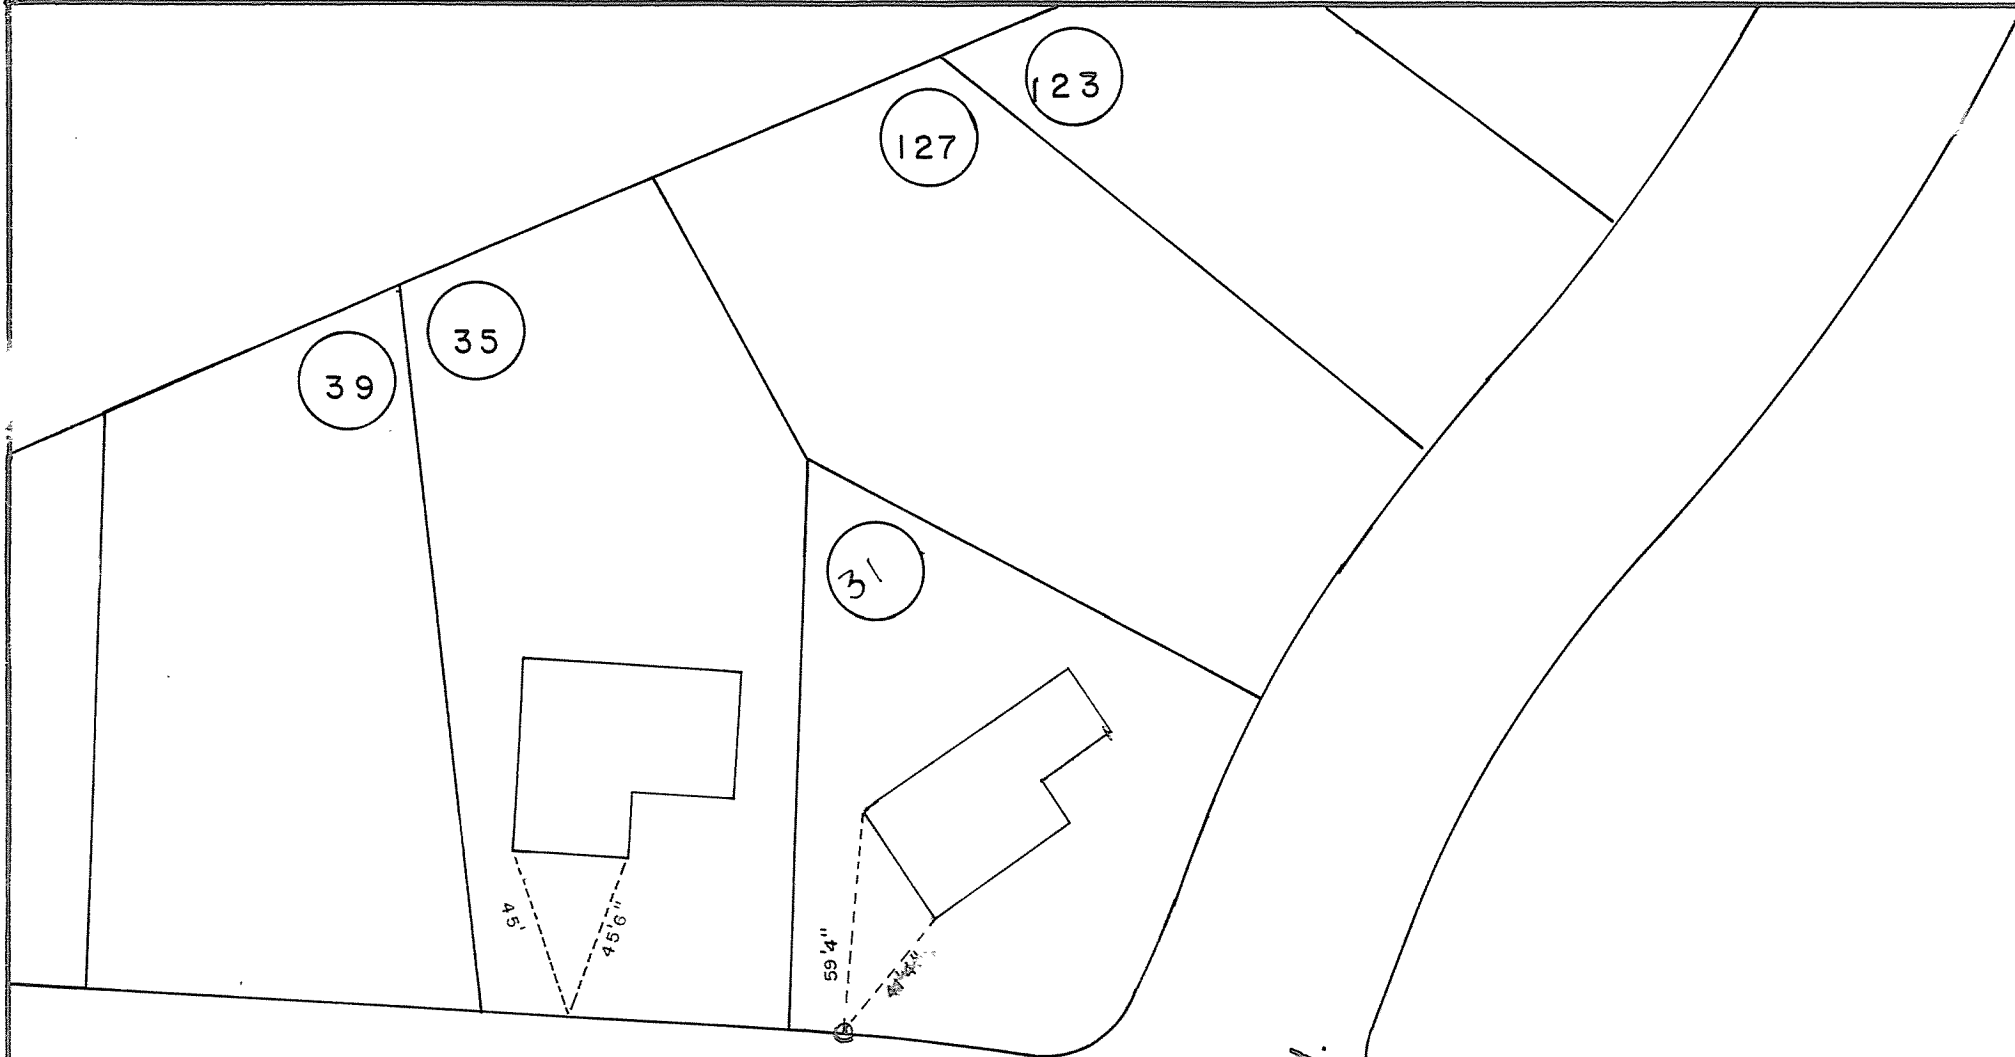

Parkwyn

Drive

Blvd.

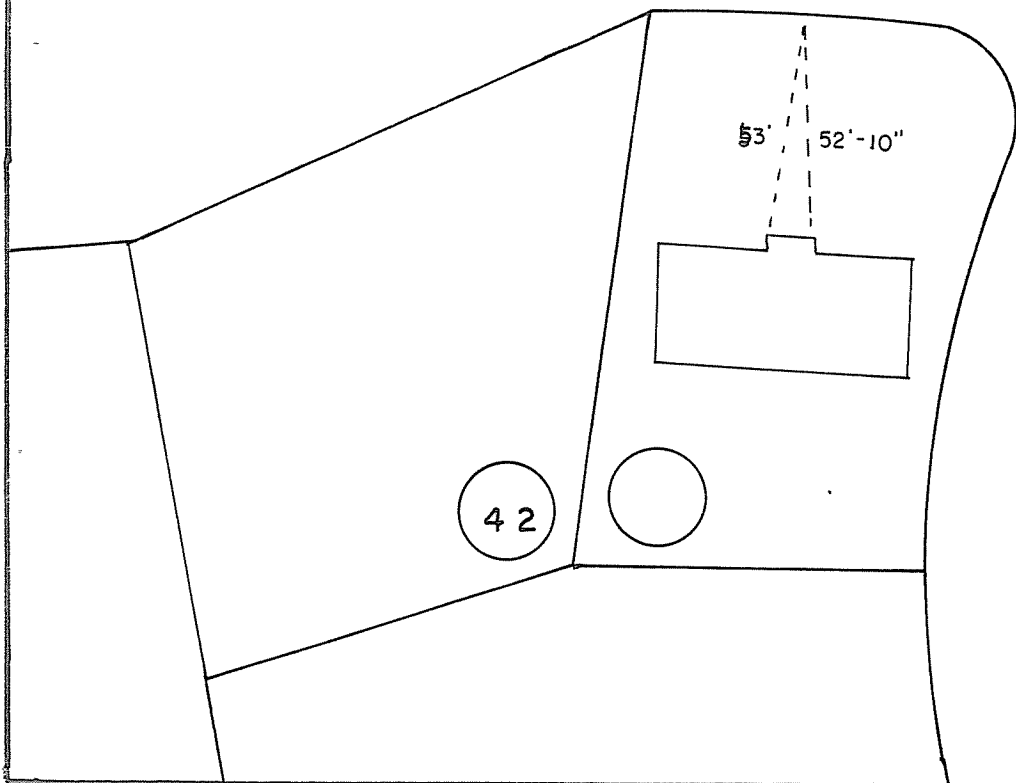

Jordan

SCALE
1" = 50'

DRAWN BY
R E B

APPROVED



PARKWYN

DRIVE

TOWN OF JORDAN
PLANNING & ZONING DEPARTMENT
11111 JORDAN AVENUE, SUITE 100
JORDAN, CA 95024
(916) 484-1234