


PARKWYN DRIVE

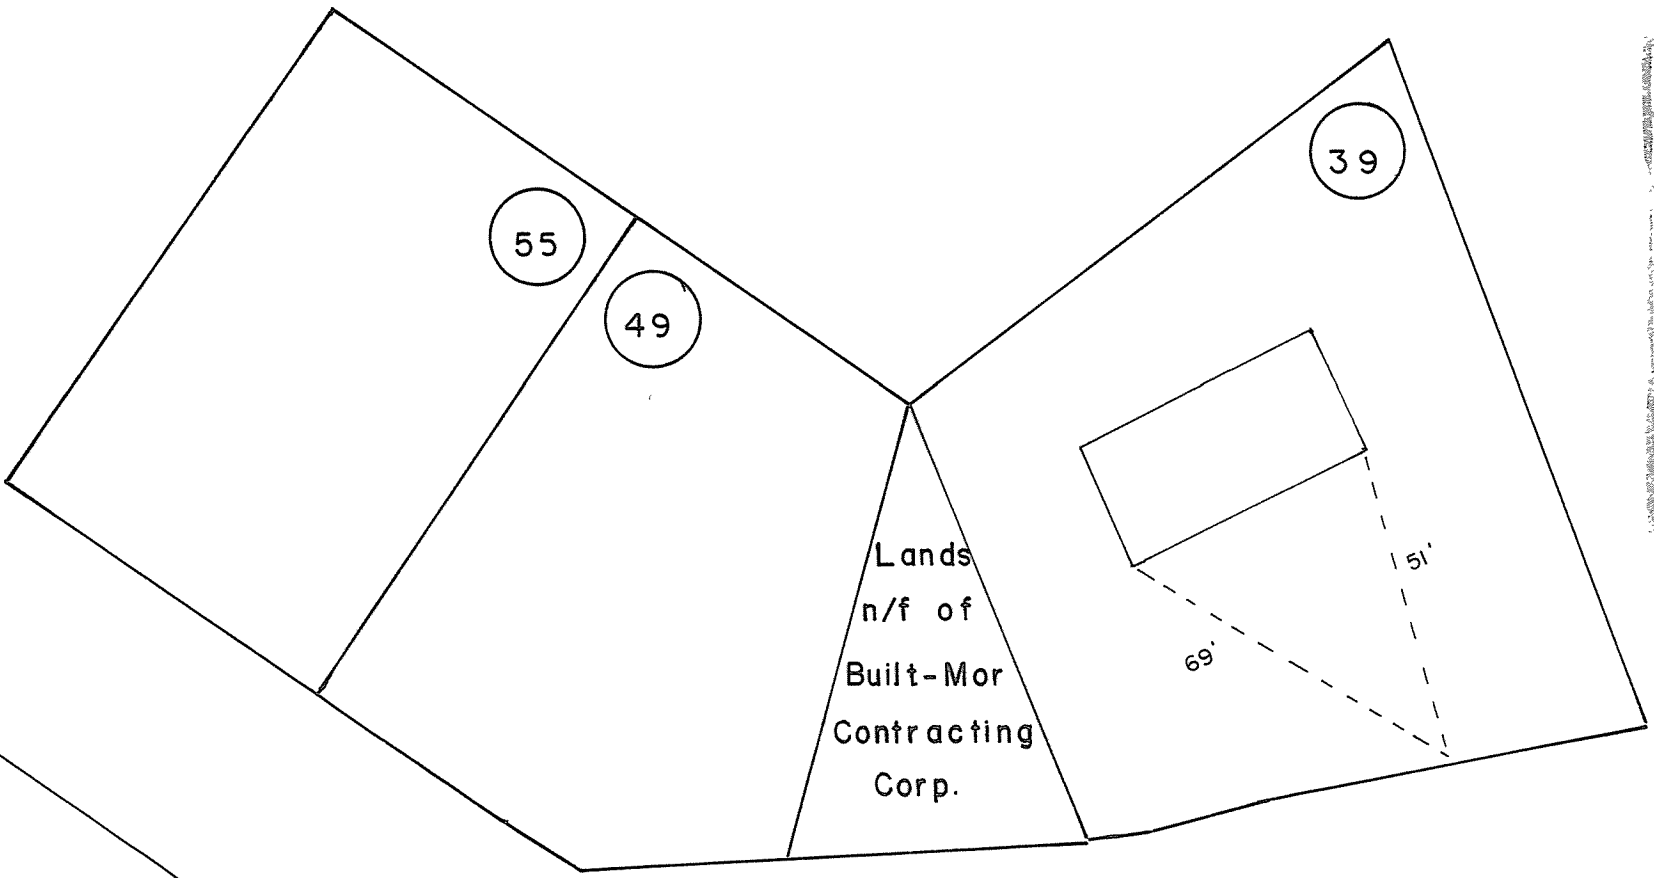

SCALE:
1" = 50'

DRAWN BY:
REB

APPROVED:

DATE:



TOWN OF SCIENCE
ENGINEERING DEPARTMENT
407 BELMONT AVE. DAYTON, OH 45424

