


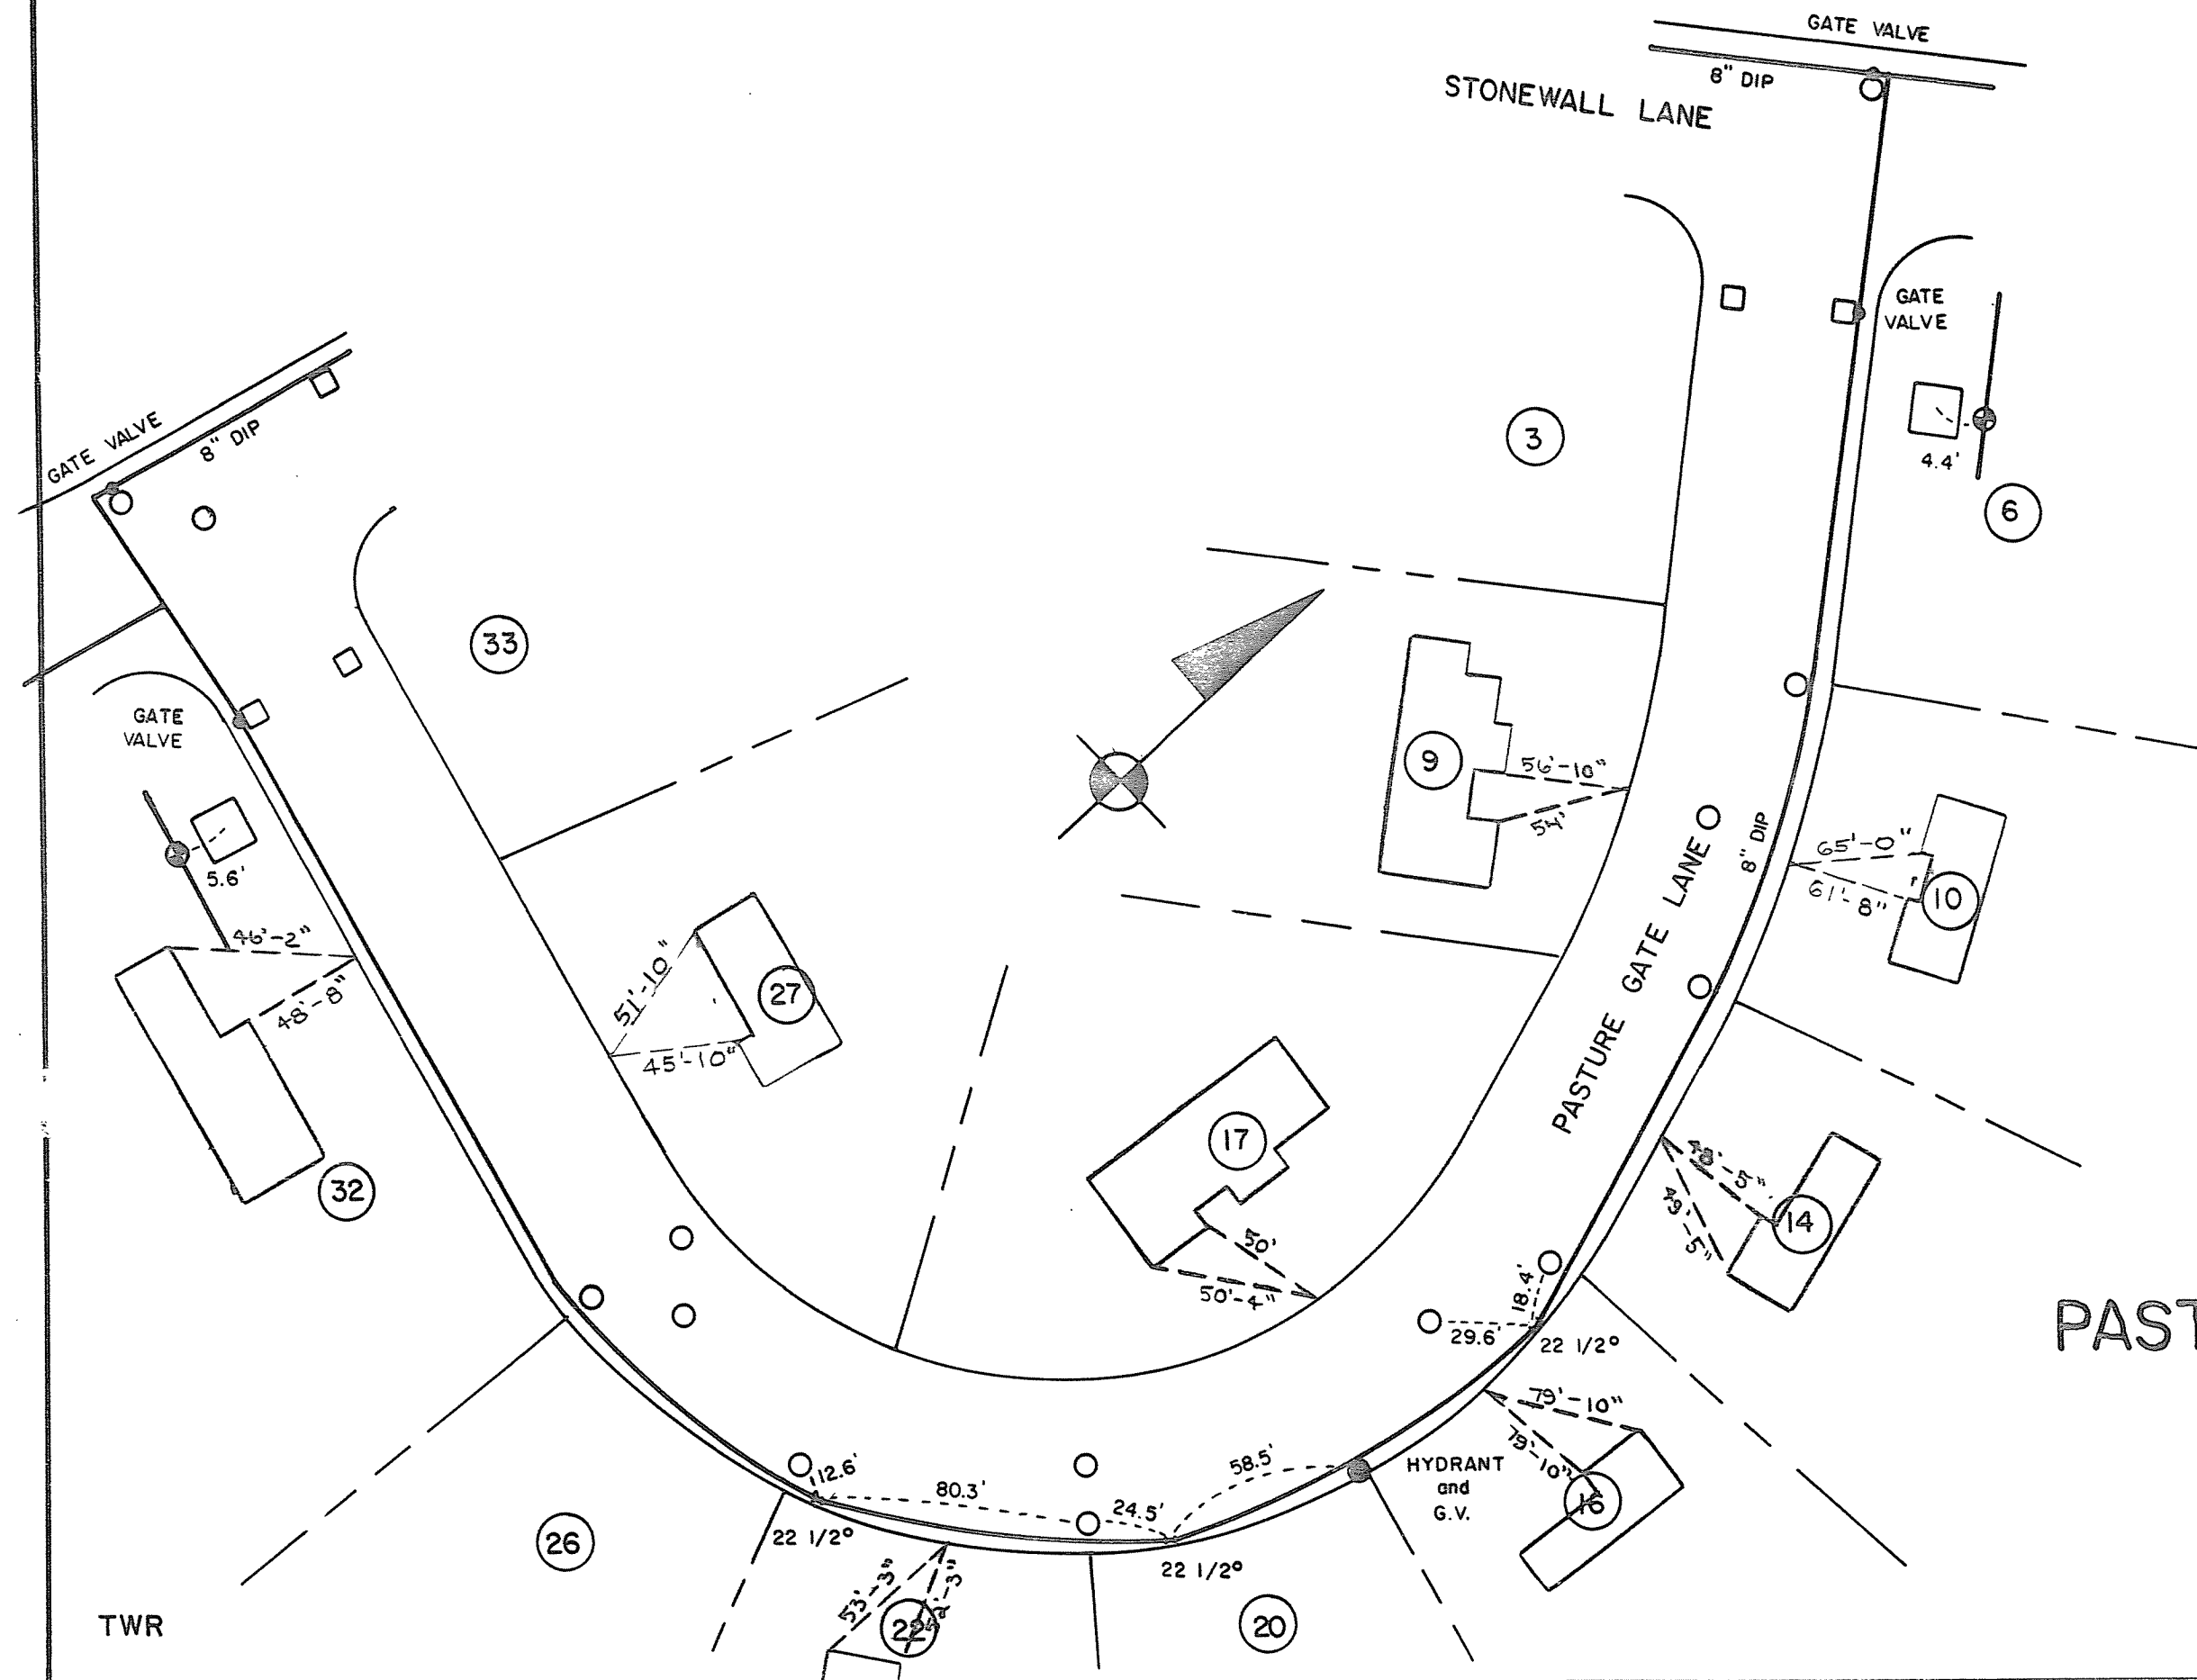

PASTURE GATE LANE
 WATER MAIN & CURB BOXES
 MARCH 1988
 1" = 50'