


TWR

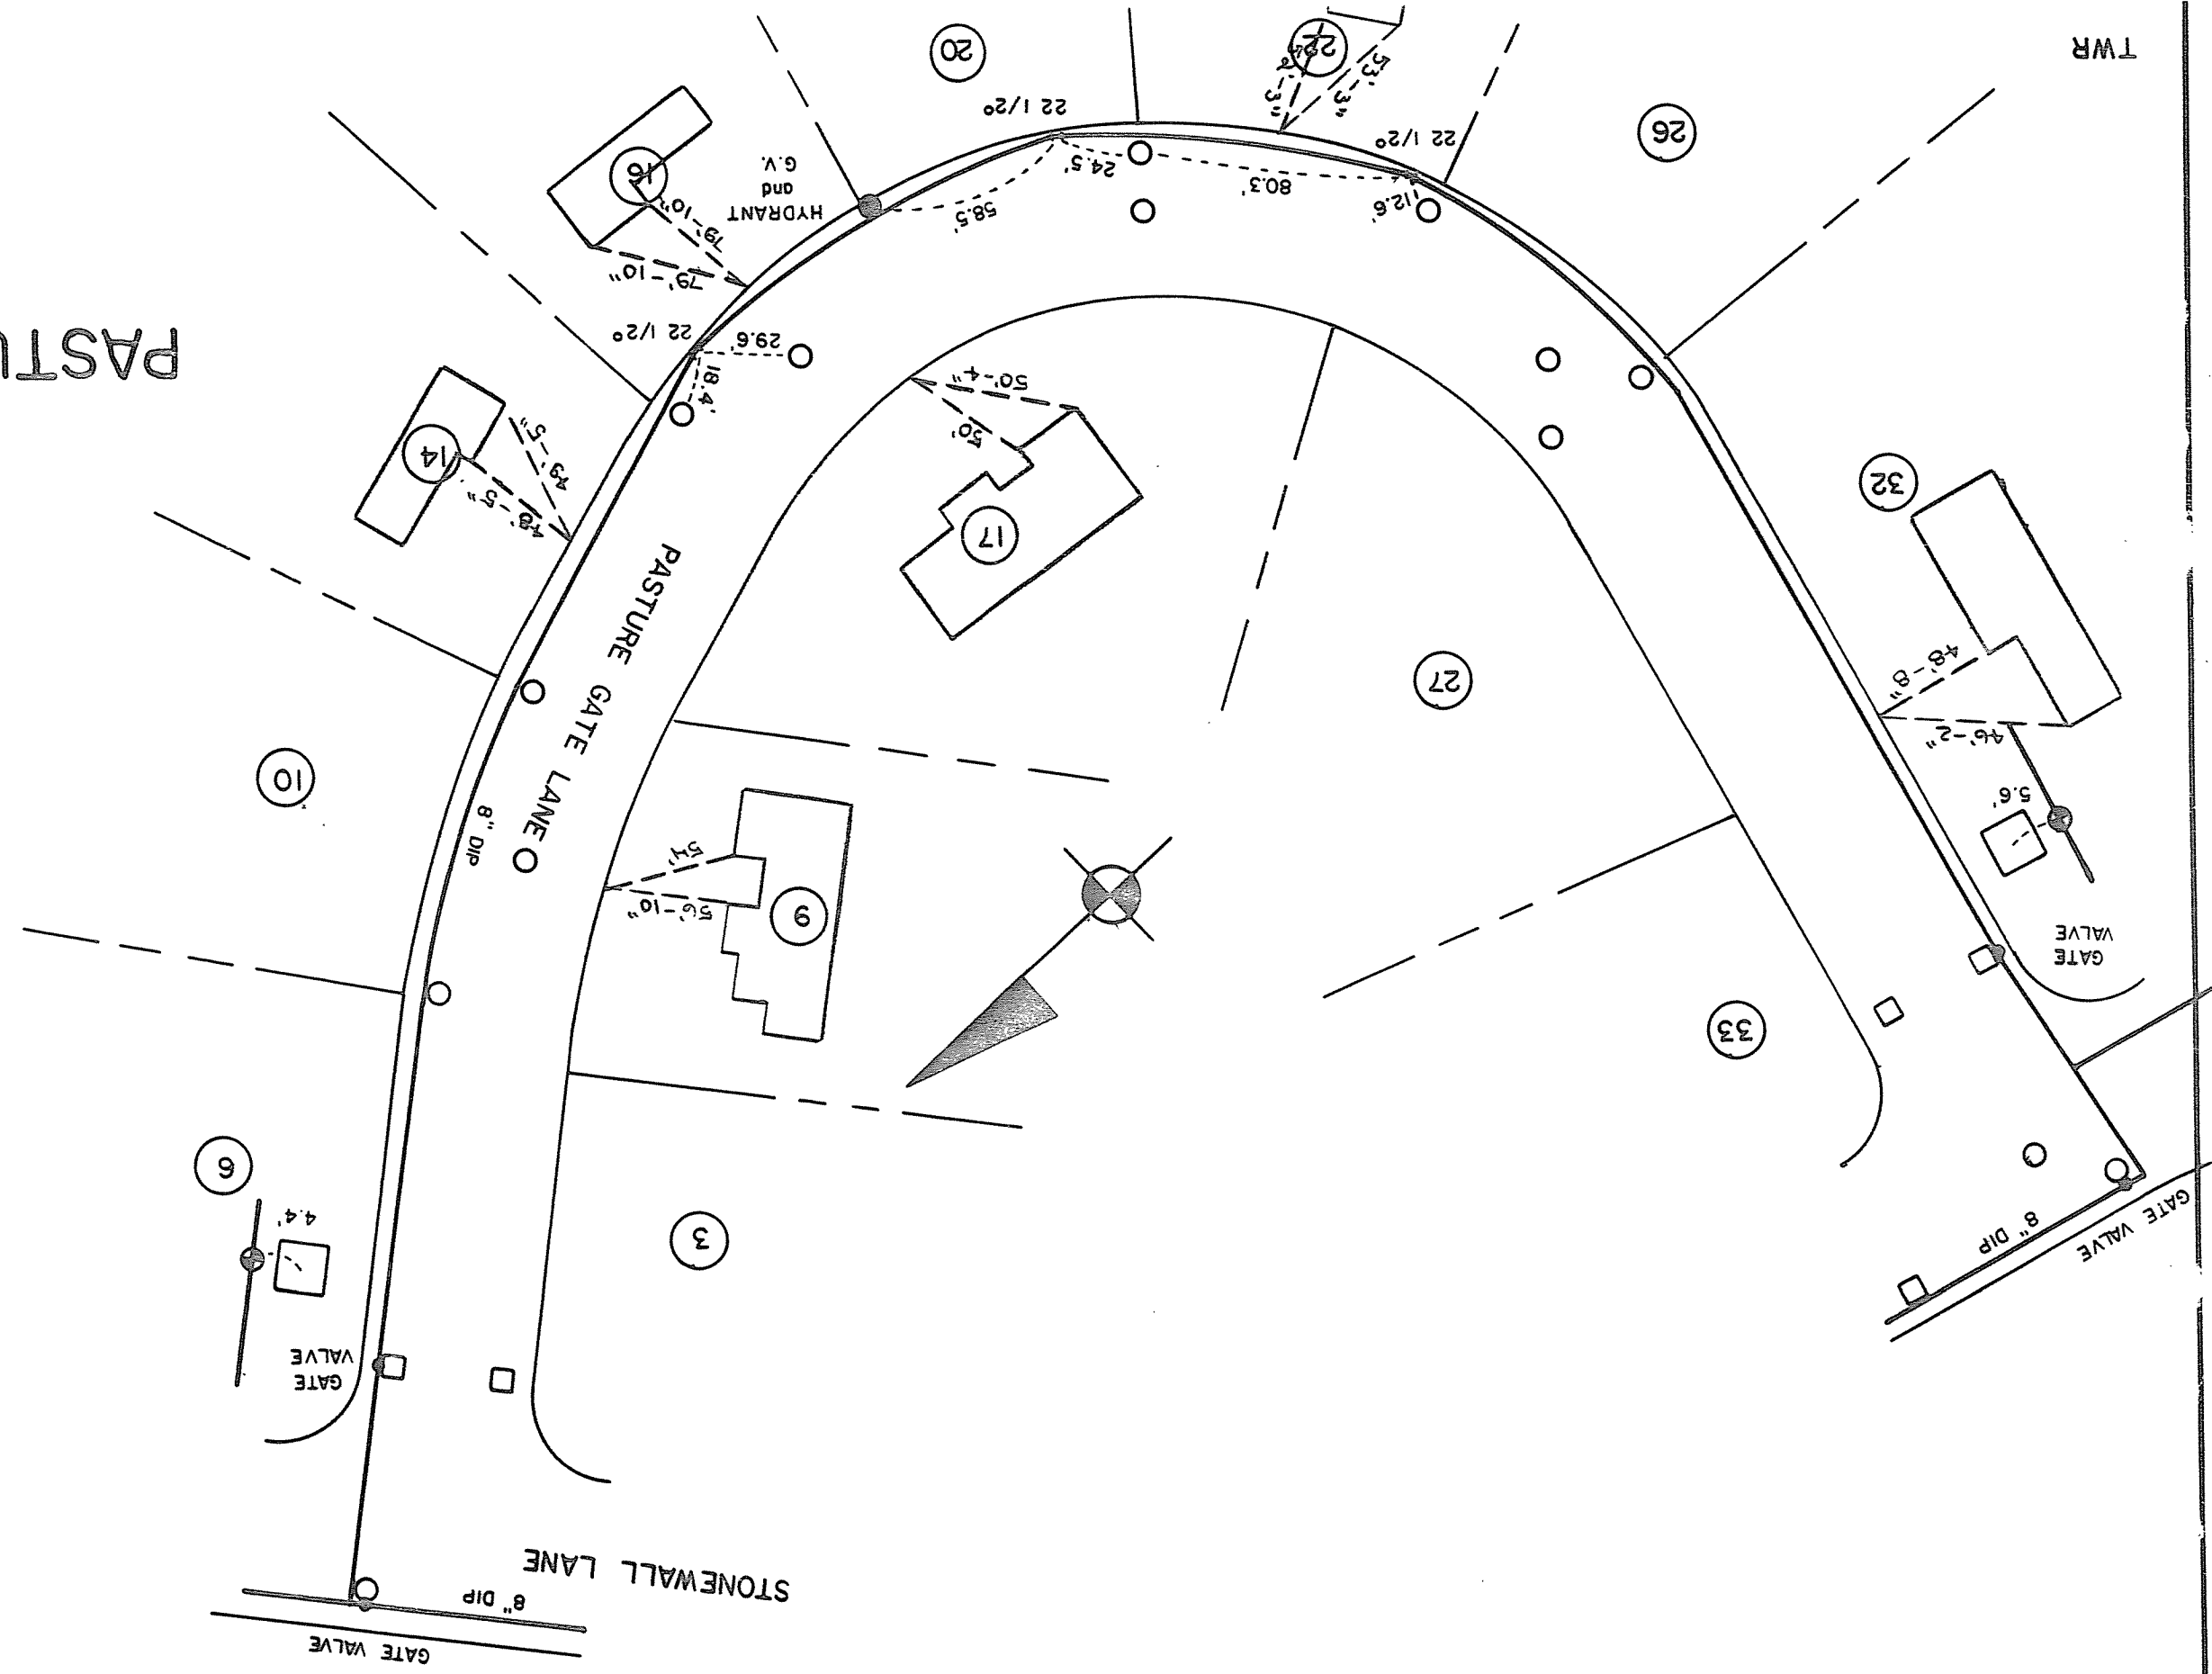

PASTURE GATE LANE
WATER MAIN & CURB BOXES
MARCH 1988
1" = 50'