


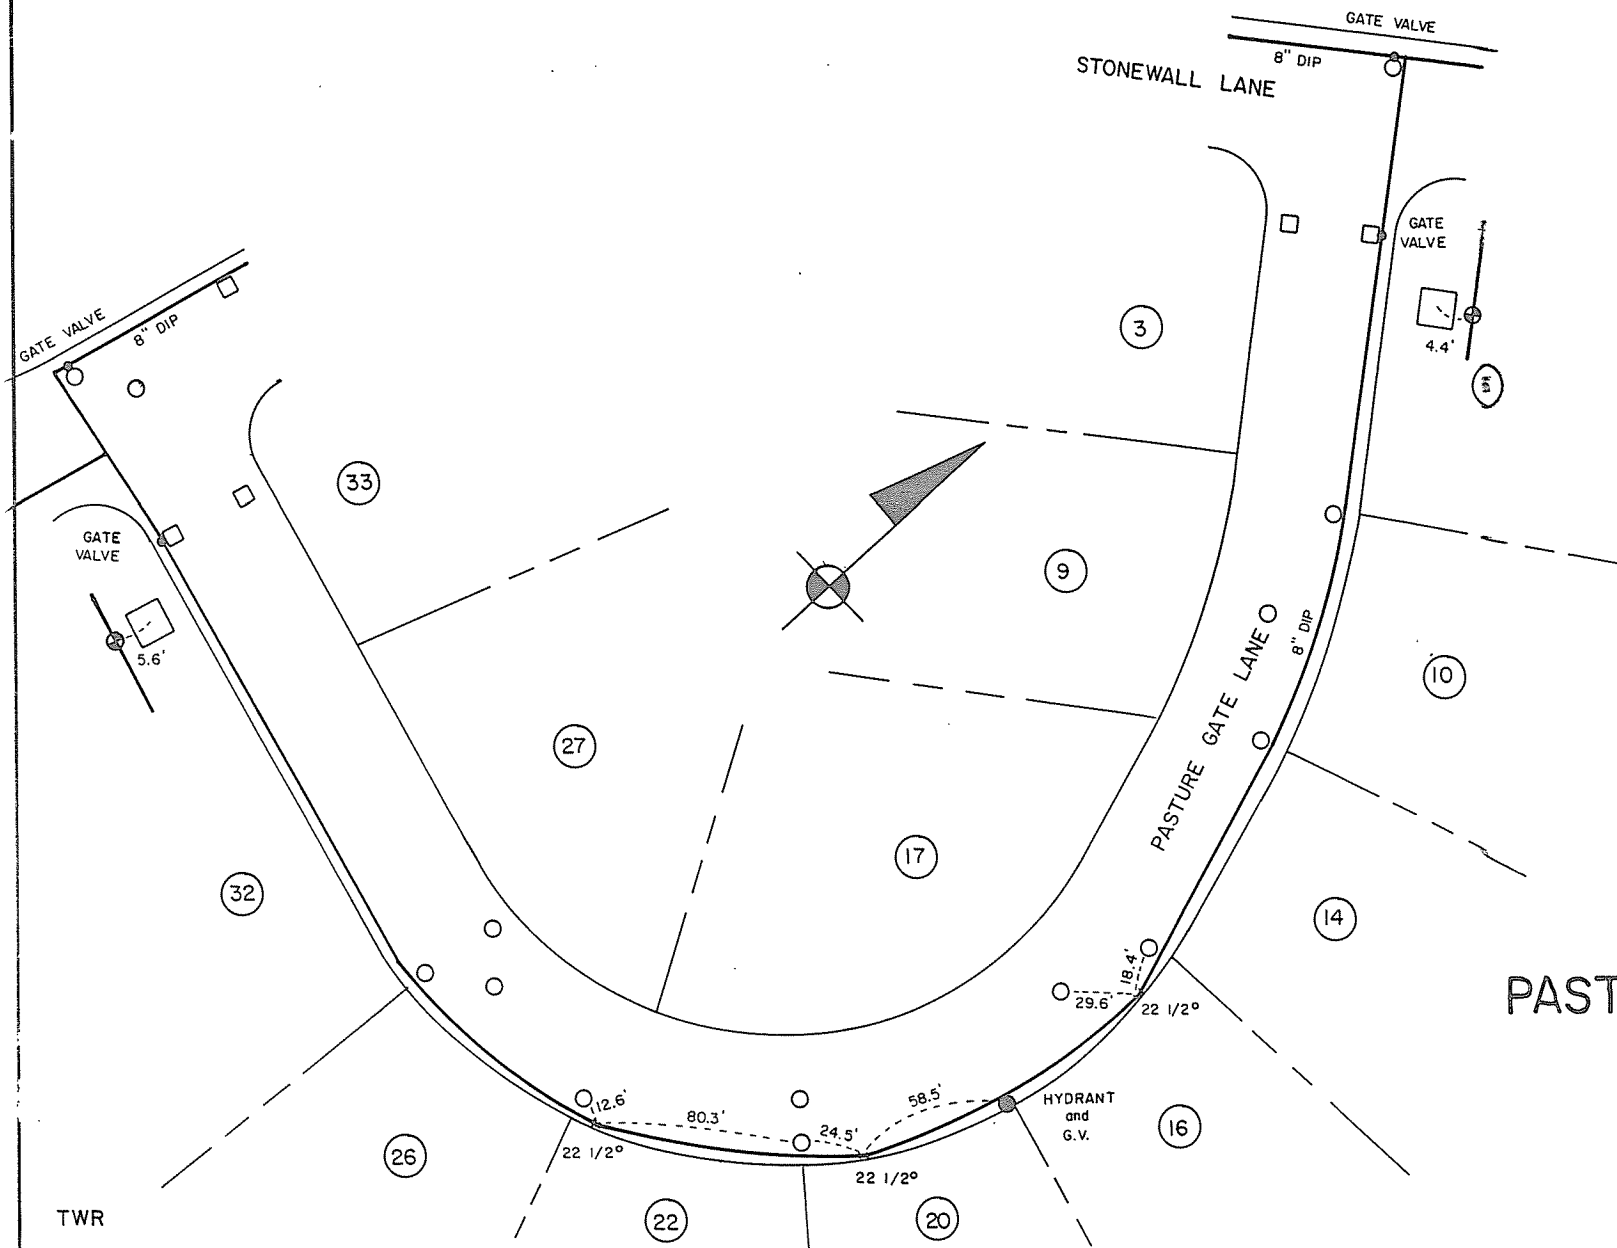

PASTURE GATE LANE

WATER MAIN

MARCH 1988

1" = 50'