


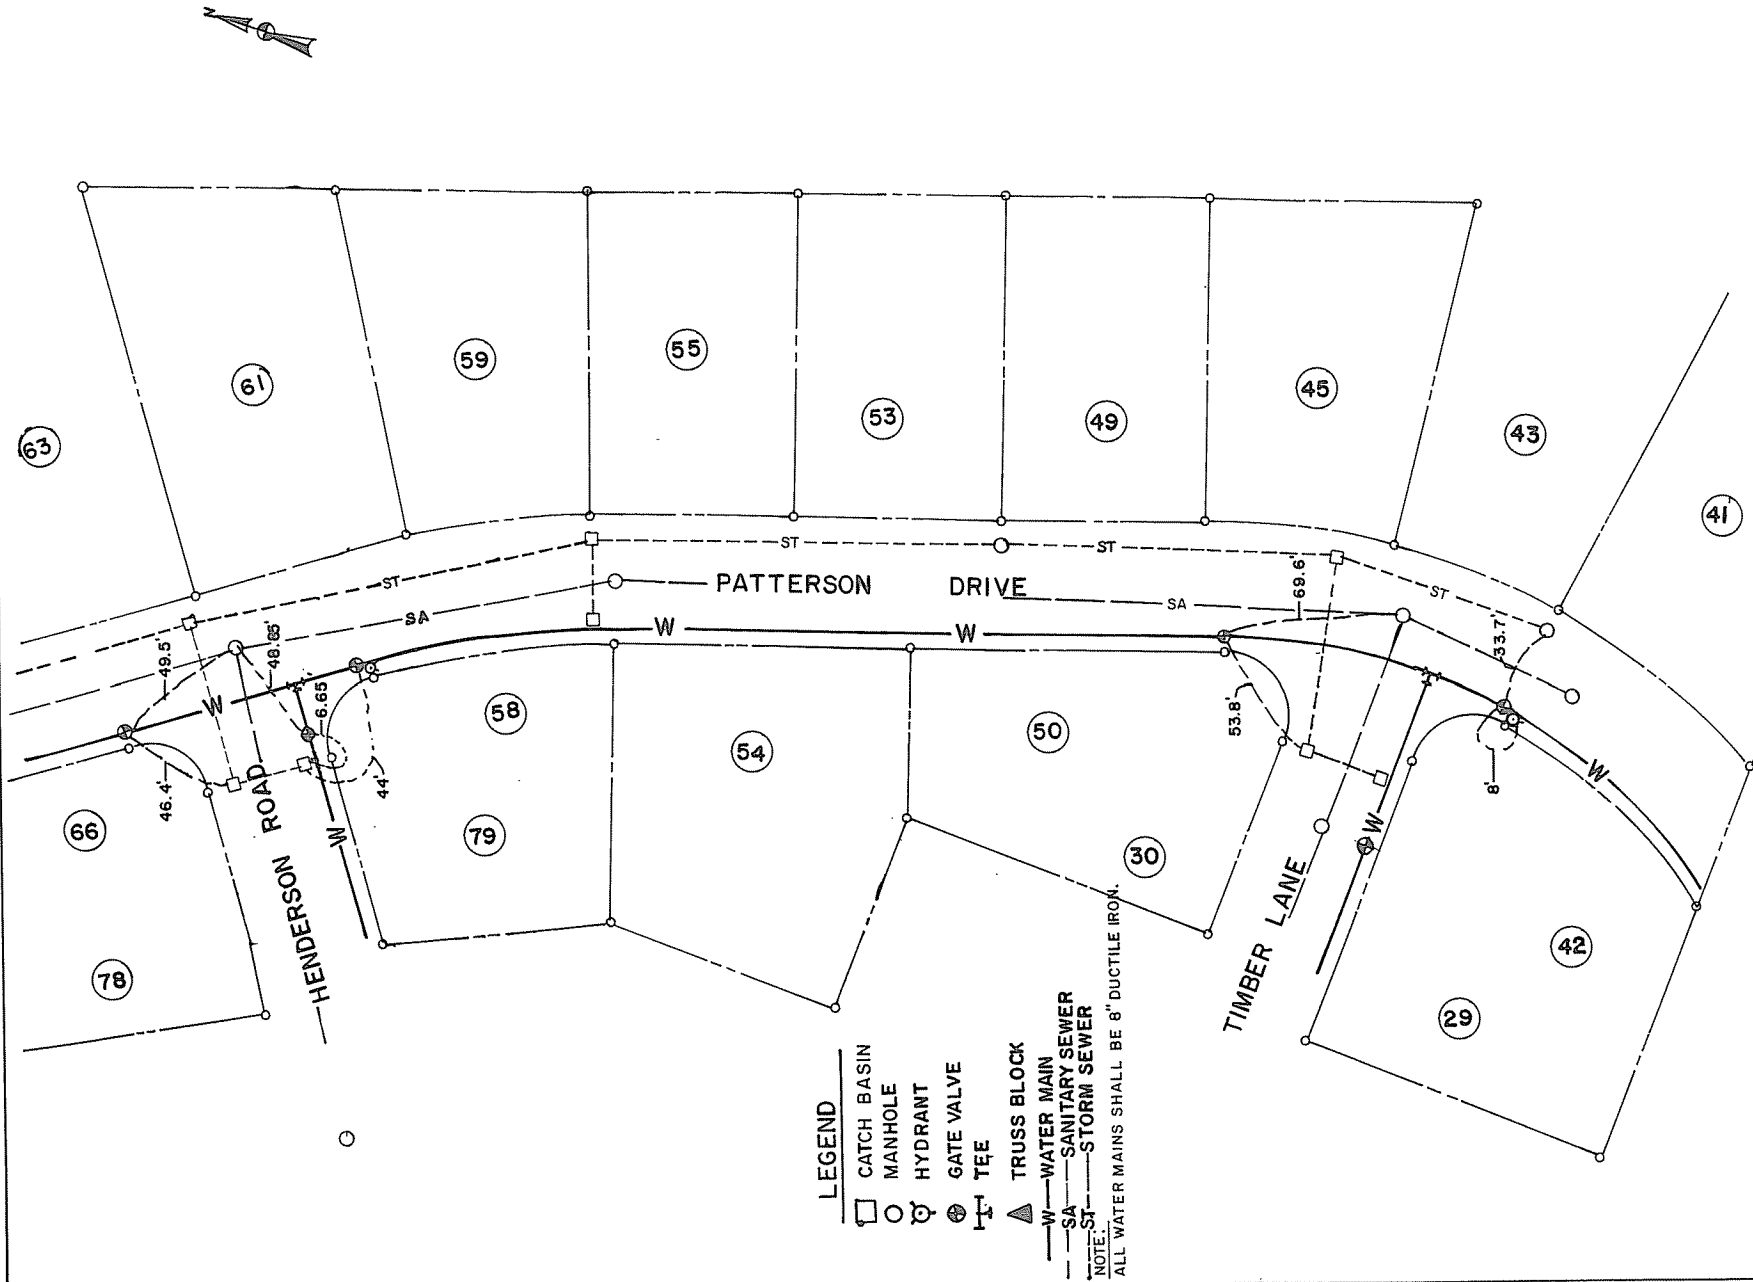

LEGEND

- CATCH BASIN
- MANHOLE
- ⊕ HYDRANT
- ⊕ GATE VALVE
- ⊕ TEE
- ▲ TRUSS BLOCK

— W — WATER MAIN
 - - - SA - - - SANITARY SEWER
 - - - ST - - - STORM SEWER

NOTE:
 ALL WATER MAINS SHALL BE 8" DUCTILE IRON.

PATTERSON DRIVE
 WATER MAIN
 SCALE: 1"=50'
 DATE: JUL. 19, 1994
 CONSTRUCTED BY HARLEN METZ
 INSPECTED BY T.C.