


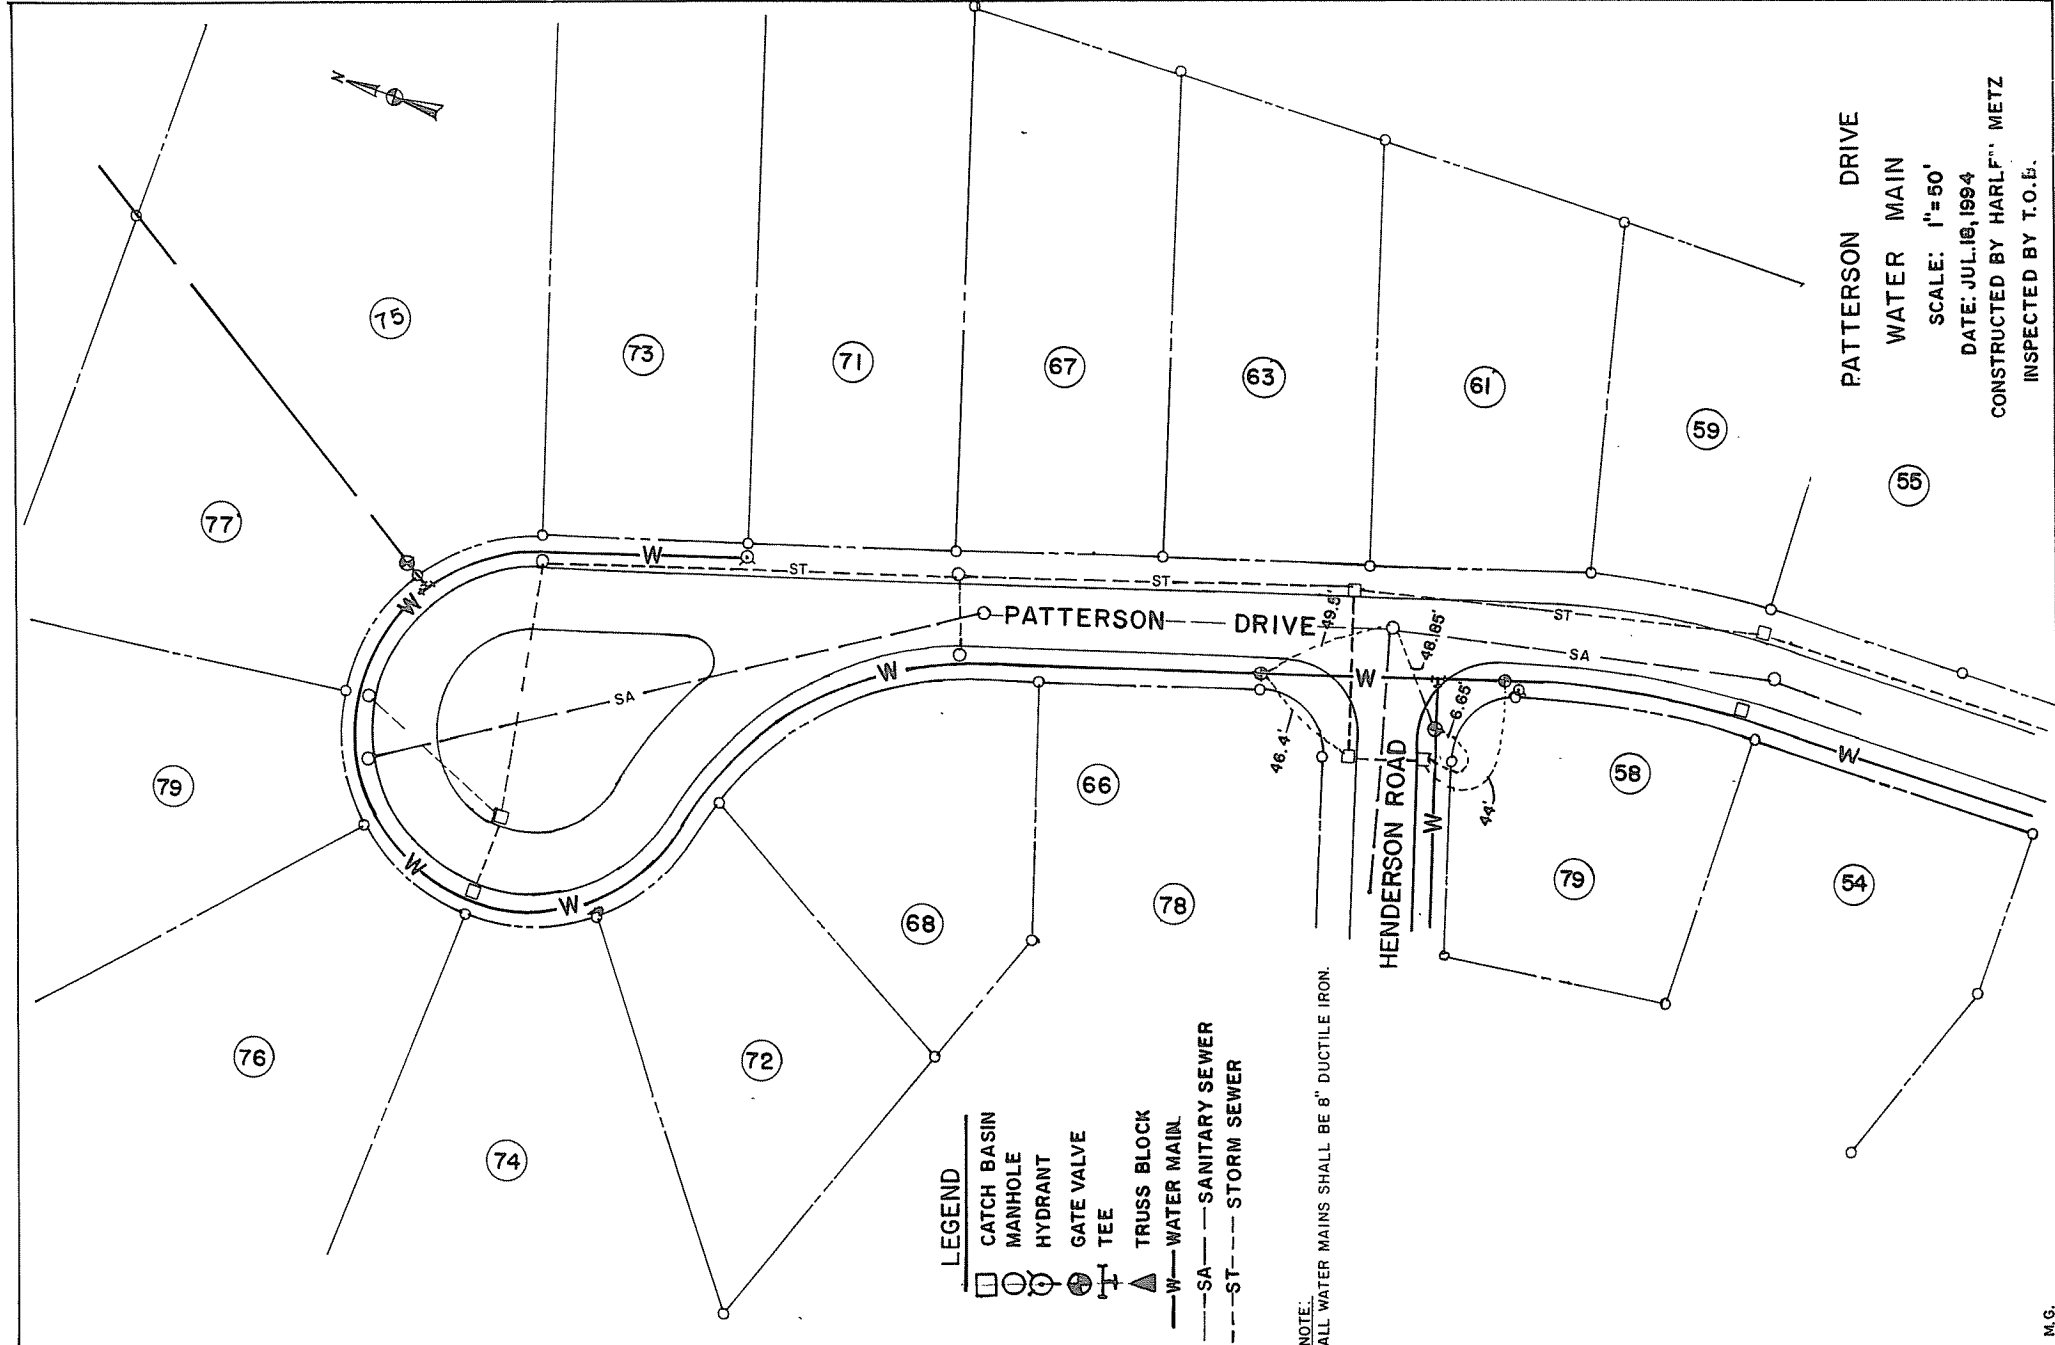

PATTERSON DRIVE

WATER MAIN

SCALE: 1" = 50'

DATE: JUL. 16, 1994

CONSTRUCTED BY HARLF" METZ

INSPECTED BY T.O.B.

Wood/Hill Sec. # 3 & 4

M.G.