


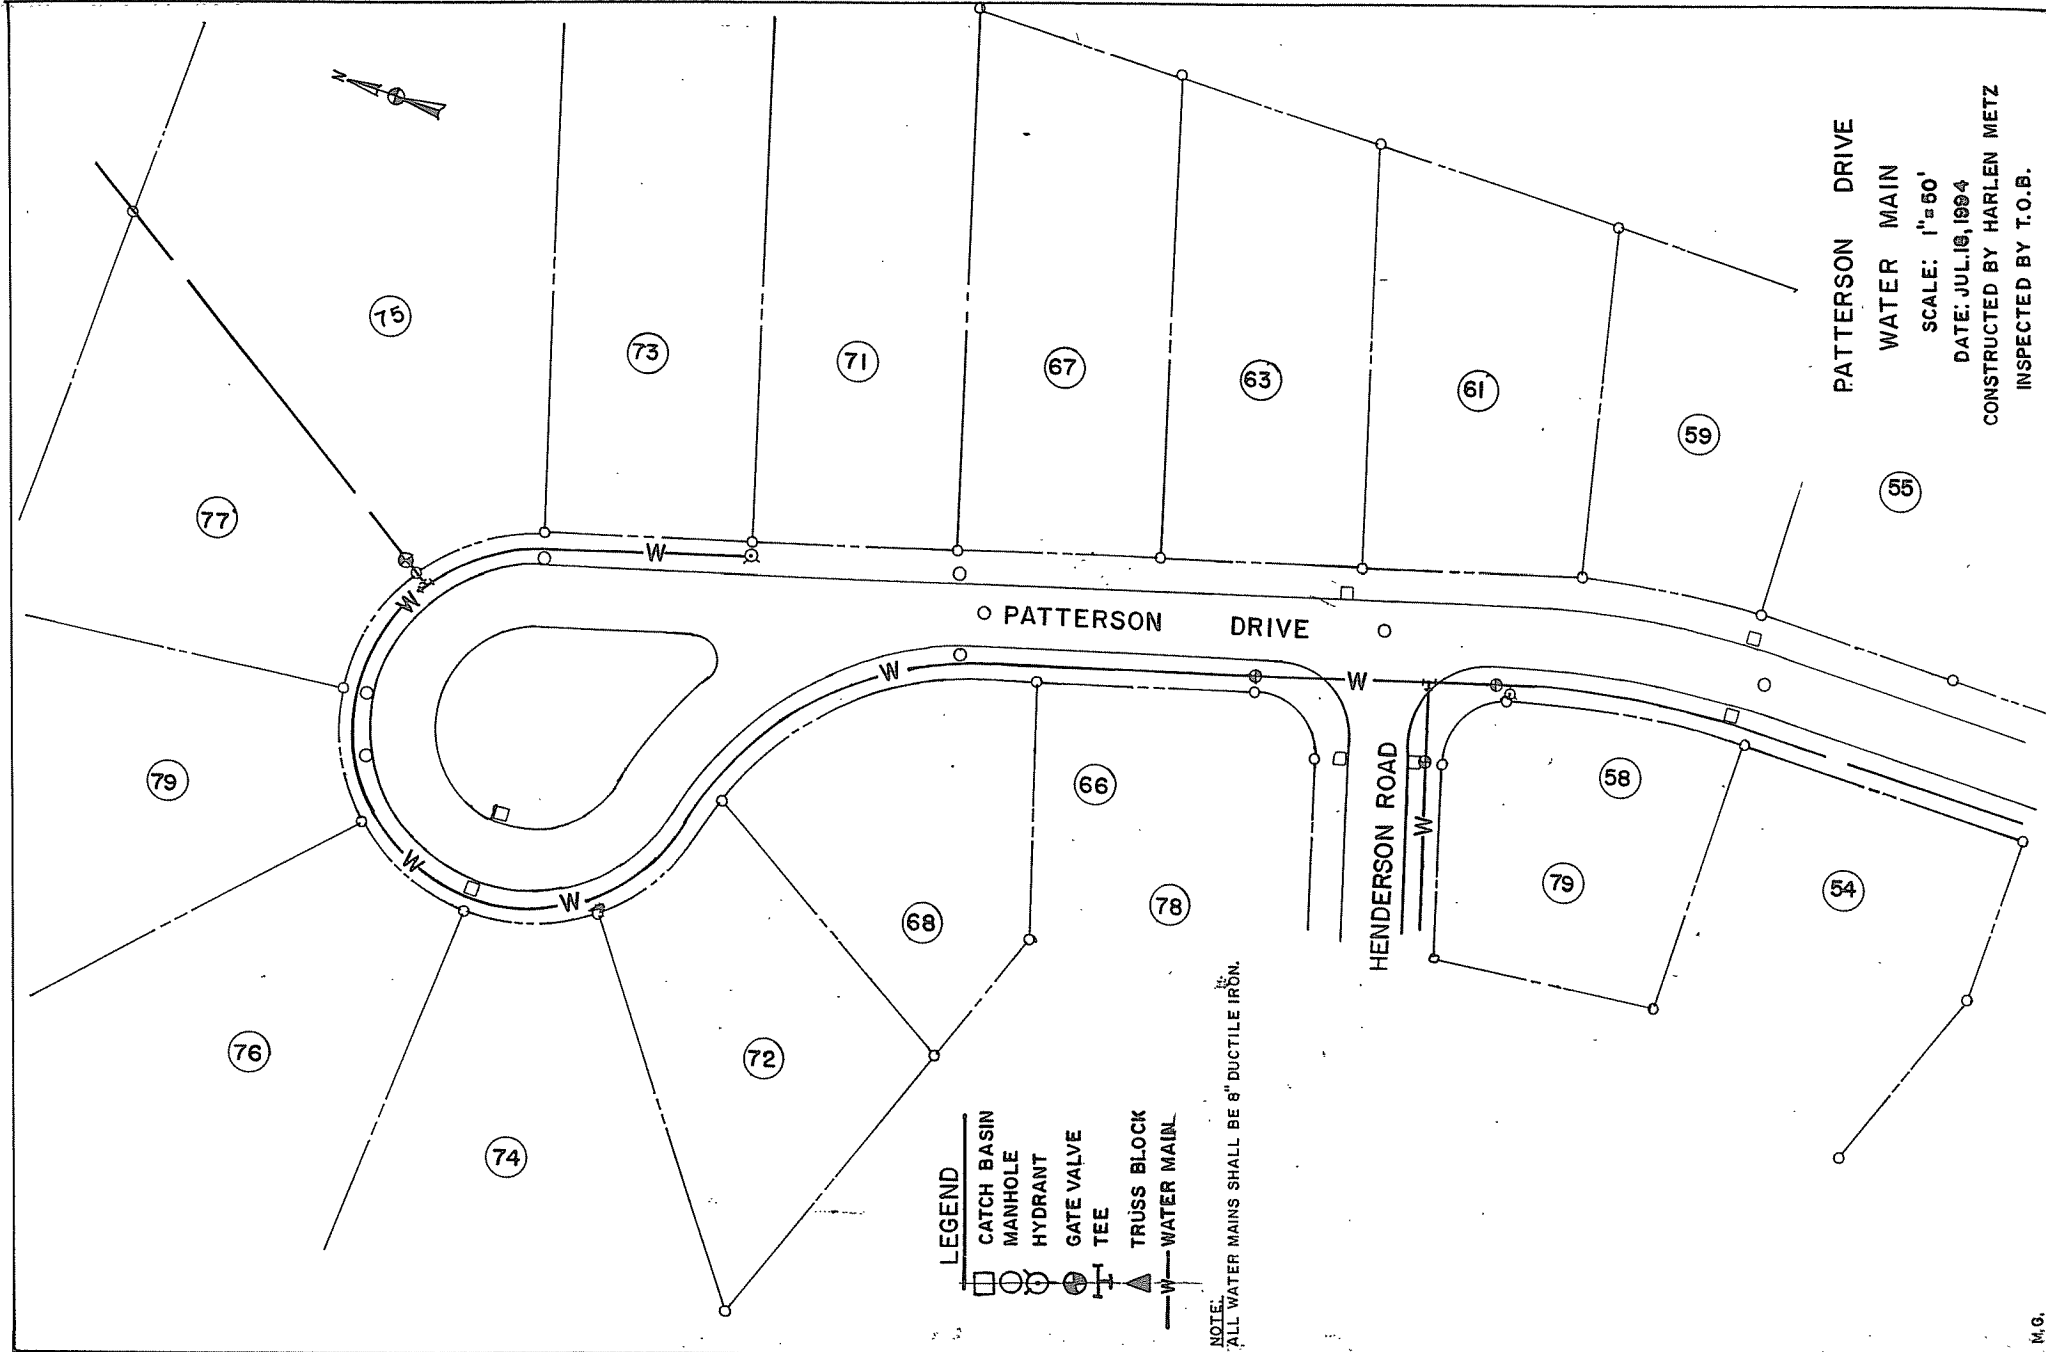

PATTERSON DRIVE
 WATER MAIN
 SCALE: 1"=50'
 DATE: JUL. 10, 1994
 CONSTRUCTED BY HARLEN METZ
 INSPECTED BY T.O.B.

Wood Hill Sta. # 384

M.G.