


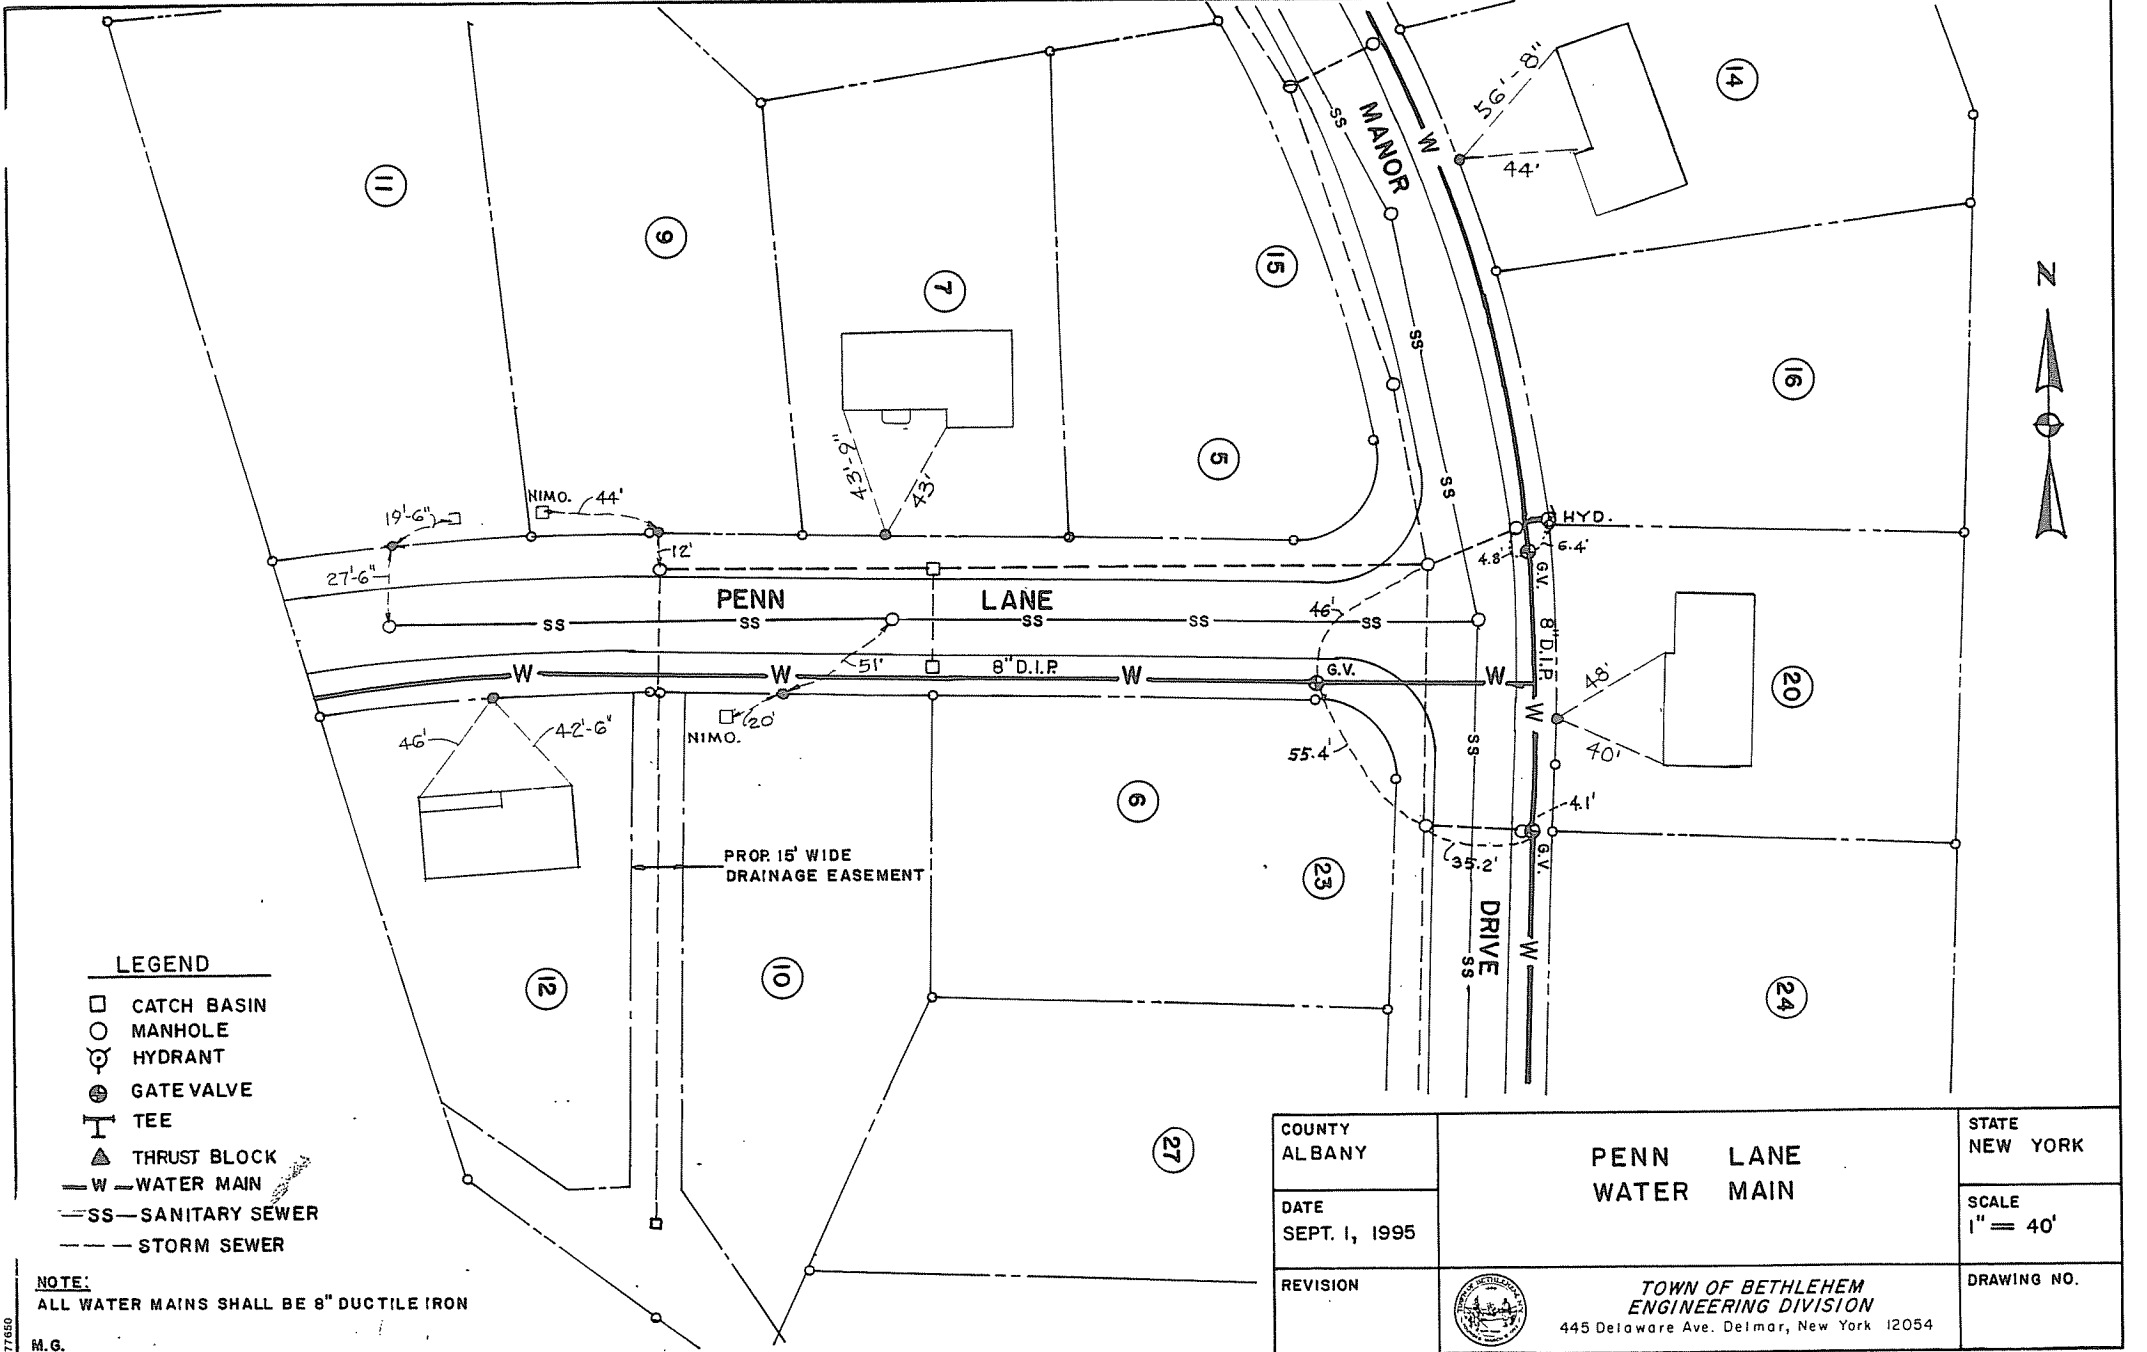

LEGEND

- CATCH BASIN
- MANHOLE
- ⊙ HYDRANT
- ⊗ GATE VALVE
- ⊥ TEE
- ▲ THRUST BLOCK
- W — WATER MAIN
- SS — SANITARY SEWER
- - - STORM SEWER

NOTE:
ALL WATER MAINS SHALL BE 8" DUCTILE IRON

COUNTY ALBANY	PENN LANE WATER MAIN	STATE NEW YORK
DATE SEPT. 1, 1995		SCALE 1" = 40'
REVISION		DRAWING NO.



TOWN OF BETHLEHEM
ENGINEERING DIVISION
445 Delaware Ave. Delmar, New York 12054

GLEN MANOR

577650

M.G.