


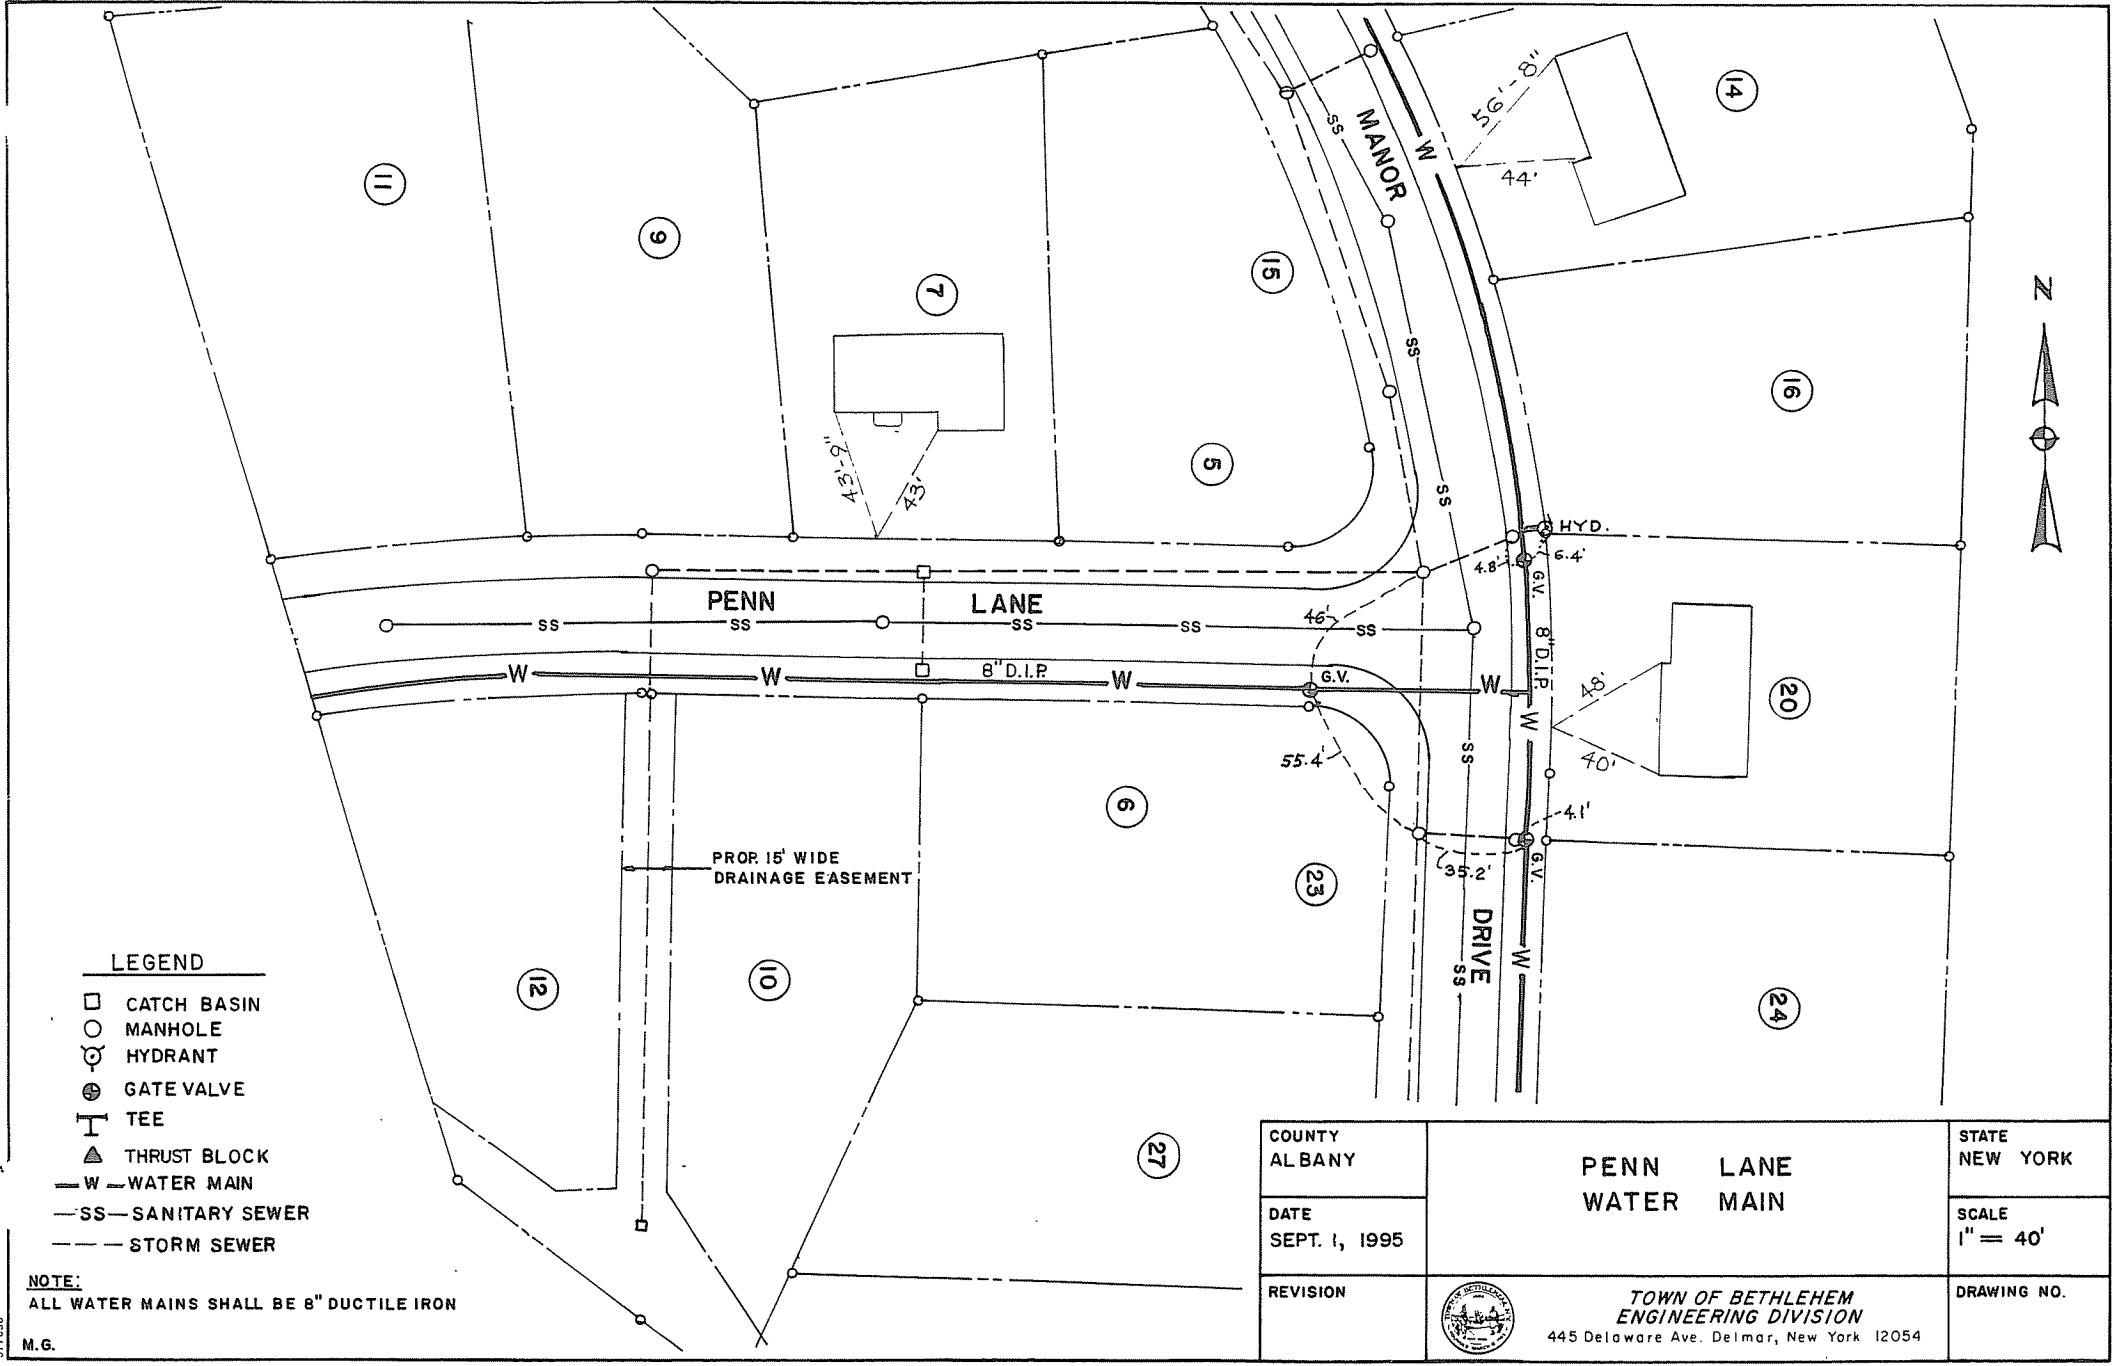

LEGEND

- CATCH BASIN
- MANHOLE
- ⊙ HYDRANT
- ⊗ GATE VALVE
- ⊥ TEE
- ▲ THRUST BLOCK
- W — WATER MAIN
- SS — SANITARY SEWER
- - - STORM SEWER

NOTE:
ALL WATER MAINS SHALL BE 6" DUCTILE IRON

M.G.

COUNTY
ALBANY

DATE
SEPT. 1, 1995

REVISION

PENN LANE
WATER MAIN



TOWN OF BETHLEHEM
ENGINEERING DIVISION
445 Delaware Ave. Delmar, New York 12054

STATE
NEW YORK

SCALE
1" = 40'

DRAWING NO.

GLEN MANOR