


PINEVIEW AVENUE  
WATER DISTRICT NO. 1  
TOWN OF BETHLEHEM  
RECORD OF INSTALLATION  
TOWN OF BETHLEHEM ENGINEERING  
DEPARTMENT  
SCALE 1"= 50' DECEMBER, 1981  
DWN BY: PDH

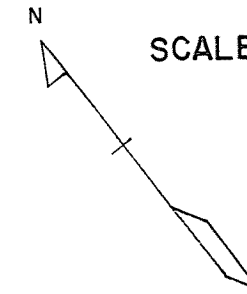

FURMAN PLACE

4

6

8

12

14

18

22

PINEVIEW AVENUE

5

9

11

15

17

19

21

51

55

59

DELMAR PLACE

