




NOT TO SCALE

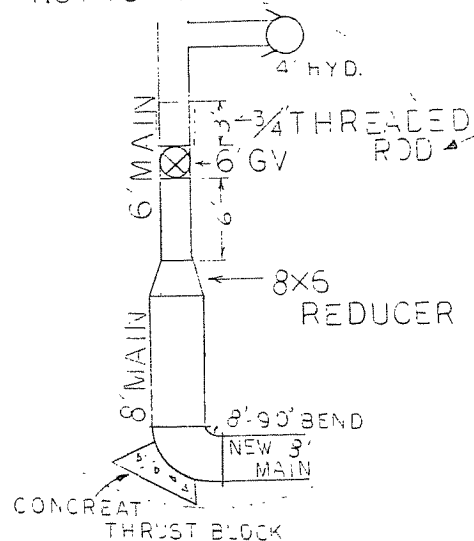

ELSWORTH AVENUE
WATER DISTRICT NO 1
TOWN OF BETHLEHEM
ENGINEERING DEPT.

SCALE 1 = 100

JUNE 10, 1980

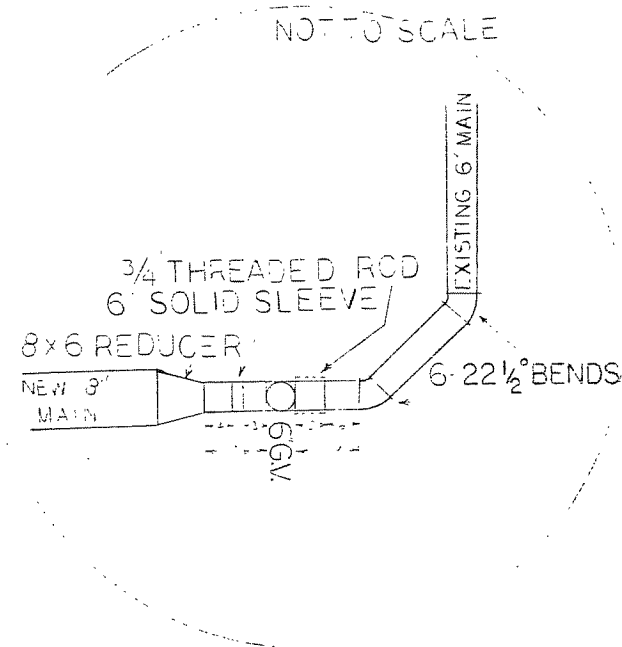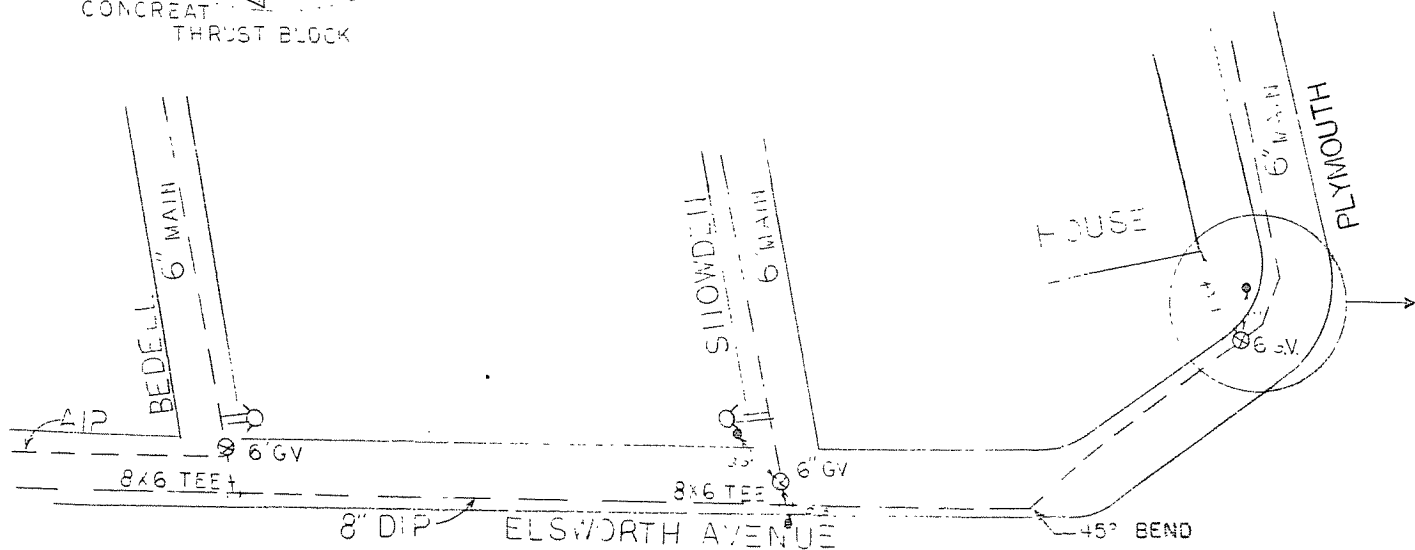

PLYMOUTH