


POPLAR DRIVE
WATER DISTRICT NO.1
TOWN OF BETHLEHEM
RECORD OF INSTALLATION
TOWN OF BETHLEHEM ENGINEERING
DEPARTMENT
SCALE: 1" = 50' MARCH, 1982
DWN. BY: PDH

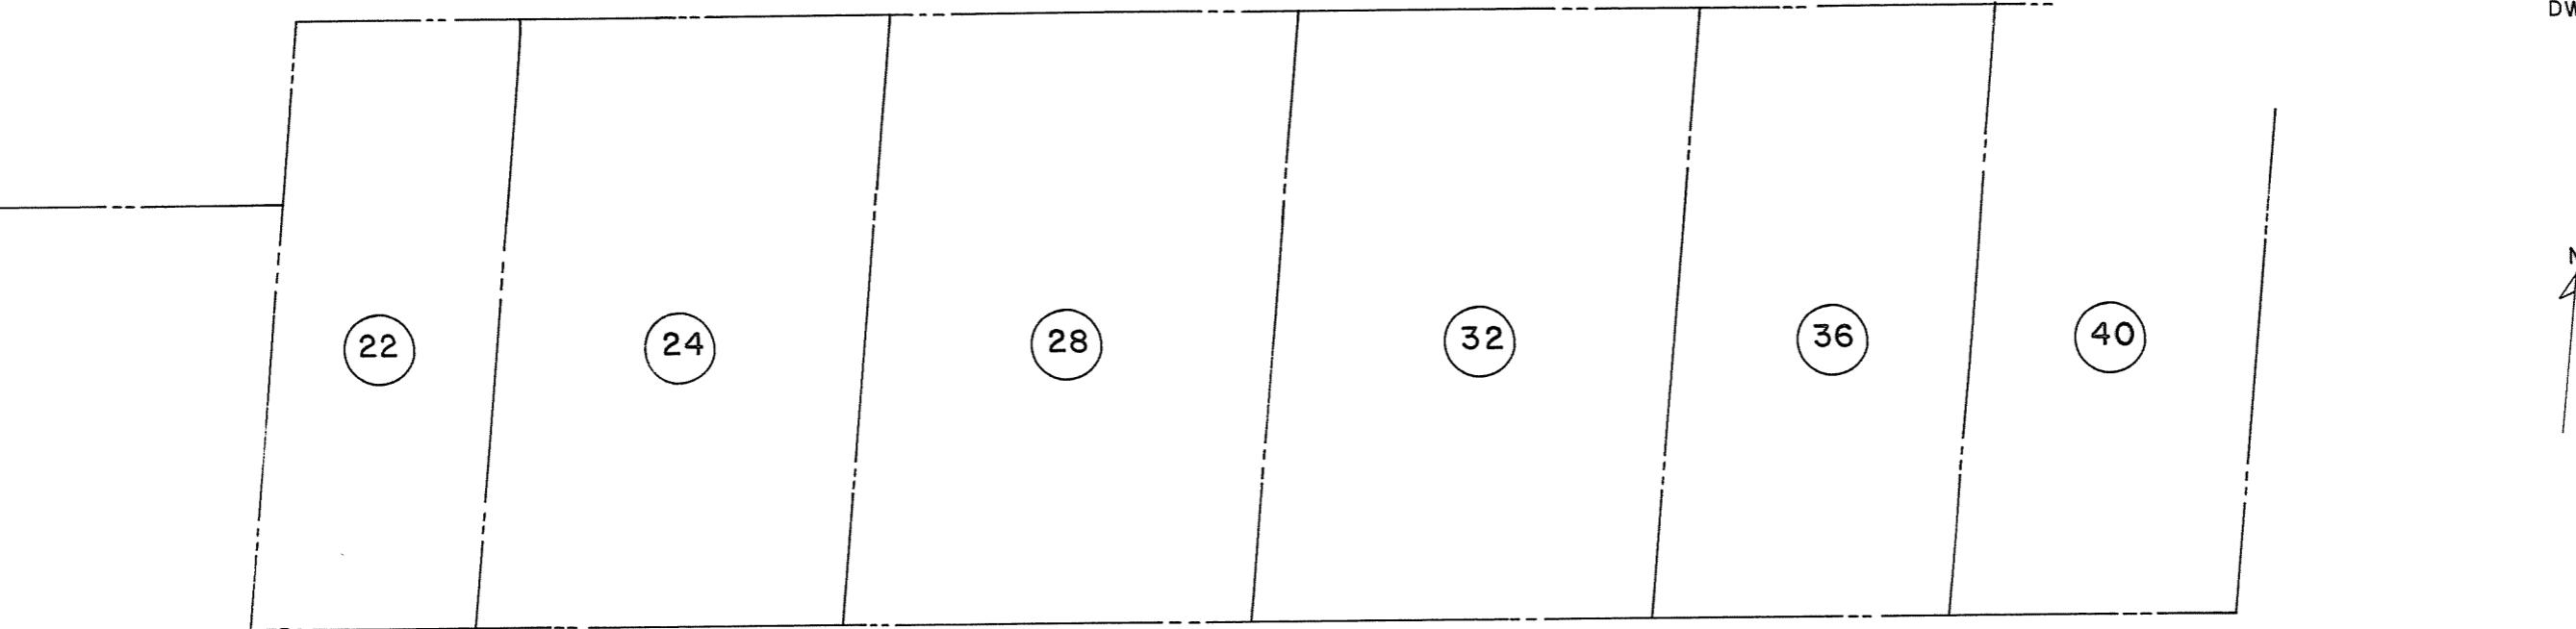

POPLAR

DRIVE

RIDGE ROAD

23

31

3

ROSE COURT

4