


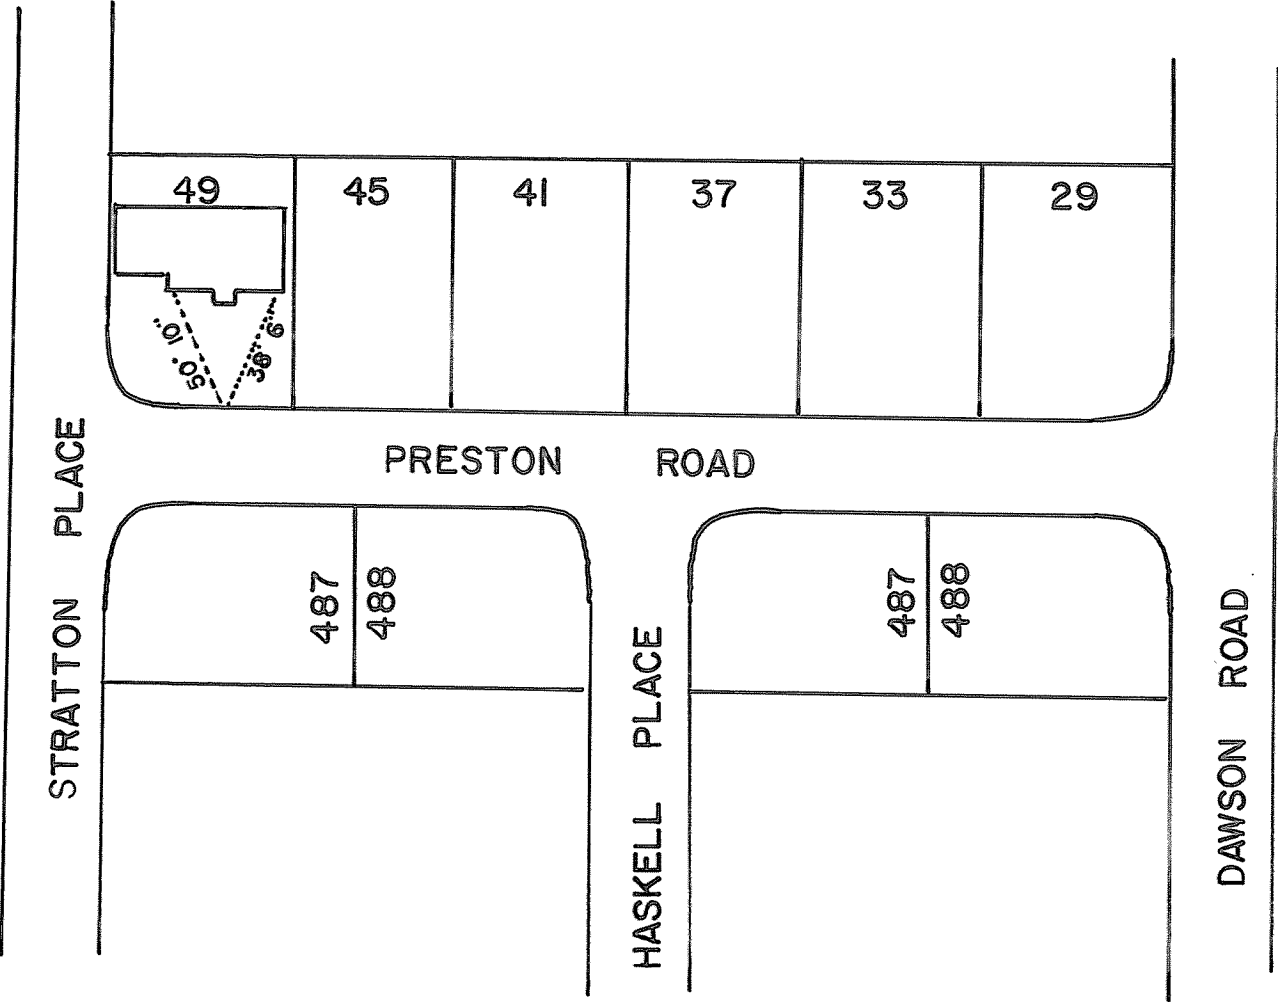

PRESTON ROAD