


977650

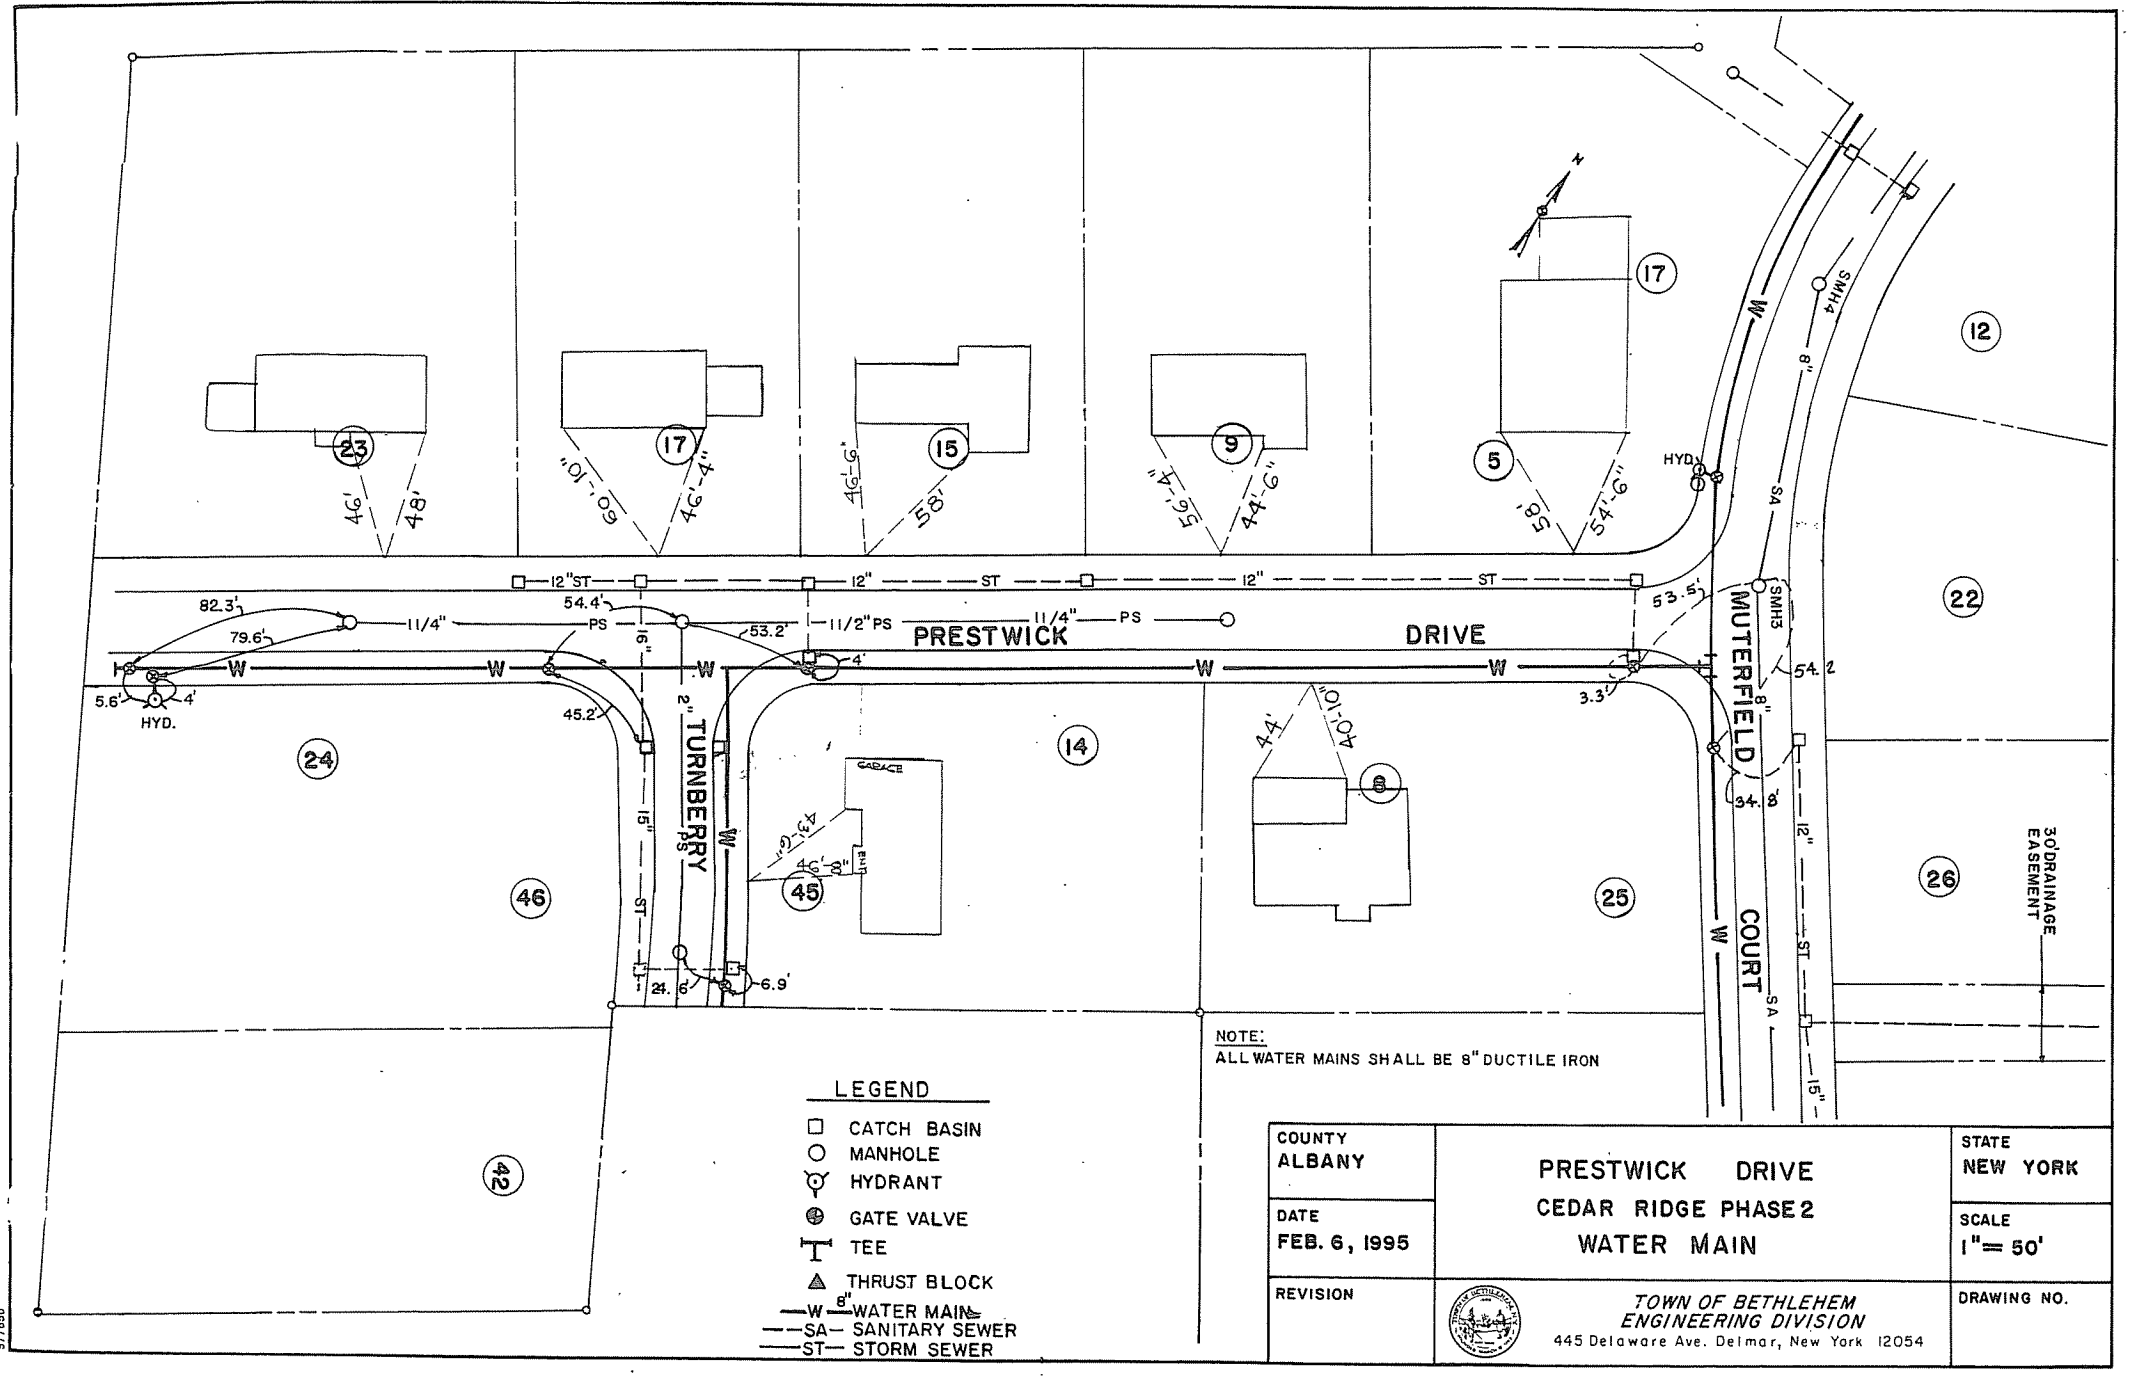

LEGEND

- CATCH BASIN
- MANHOLE
- ⊙ HYDRANT
- ⊕ GATE VALVE
- ⊥ TEE
- ▲ THRUST BLOCK
- W— 8" WATER MAIN
- SA— 8" SANITARY SEWER
- ST— 8" STORM SEWER

NOTE:
ALL WATER MAINS SHALL BE 8" DUCTILE IRON

COUNTY ALBANY	PRESTWICK DRIVE CEDAR RIDGE PHASE2 WATER MAIN	STATE NEW YORK
DATE FEB. 6, 1995		SCALE 1" = 50'
REVISION	 TOWN OF BETHLEHEM ENGINEERING DIVISION 445 Delaware Ave. Delmar, New York 12054	DRAWING NO.