


577550

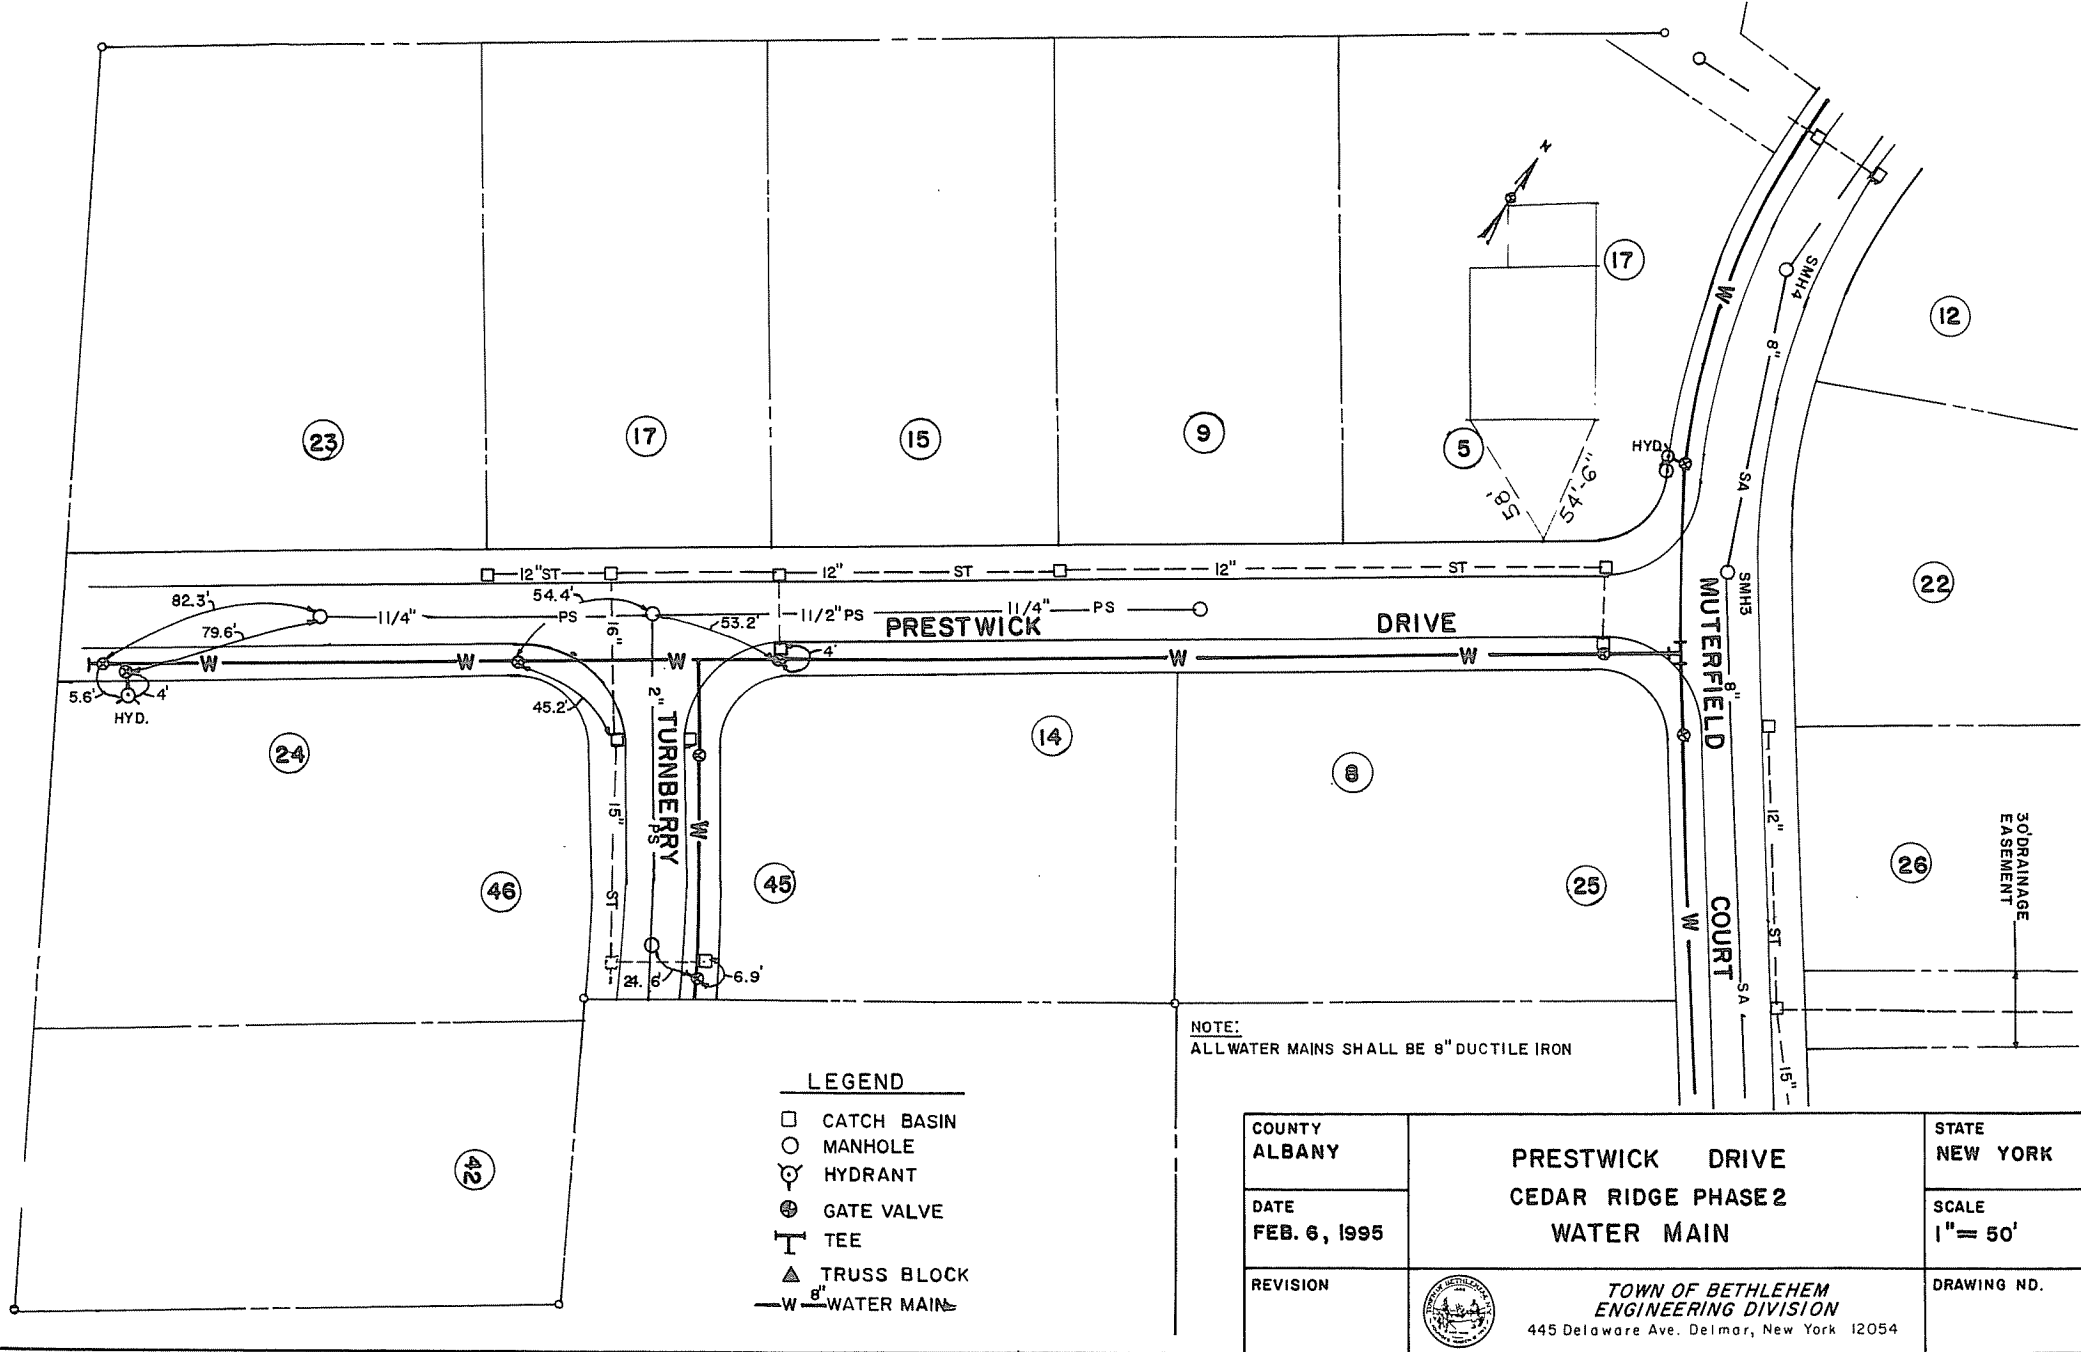

- LEGEND**
- CATCH BASIN
 - MANHOLE
 - ⊙ HYDRANT
 - ⊕ GATE VALVE
 - ⊥ TEE
 - ▲ TRUSS BLOCK
 - W— 8" WATER MAIN

NOTE:
ALL WATER MAINS SHALL BE 8" DUCTILE IRON

COUNTY ALBANY	PRESTWICK DRIVE CEDAR RIDGE PHASE 2 WATER MAIN	STATE NEW YORK
DATE FEB. 6, 1995		SCALE 1" = 50'
REVISION	 TOWN OF BETHLEHEM ENGINEERING DIVISION 445 Delaware Ave. Delmar, New York 12054	DRAWING NO.