


TOWN HIGHWAY GARAGE

74

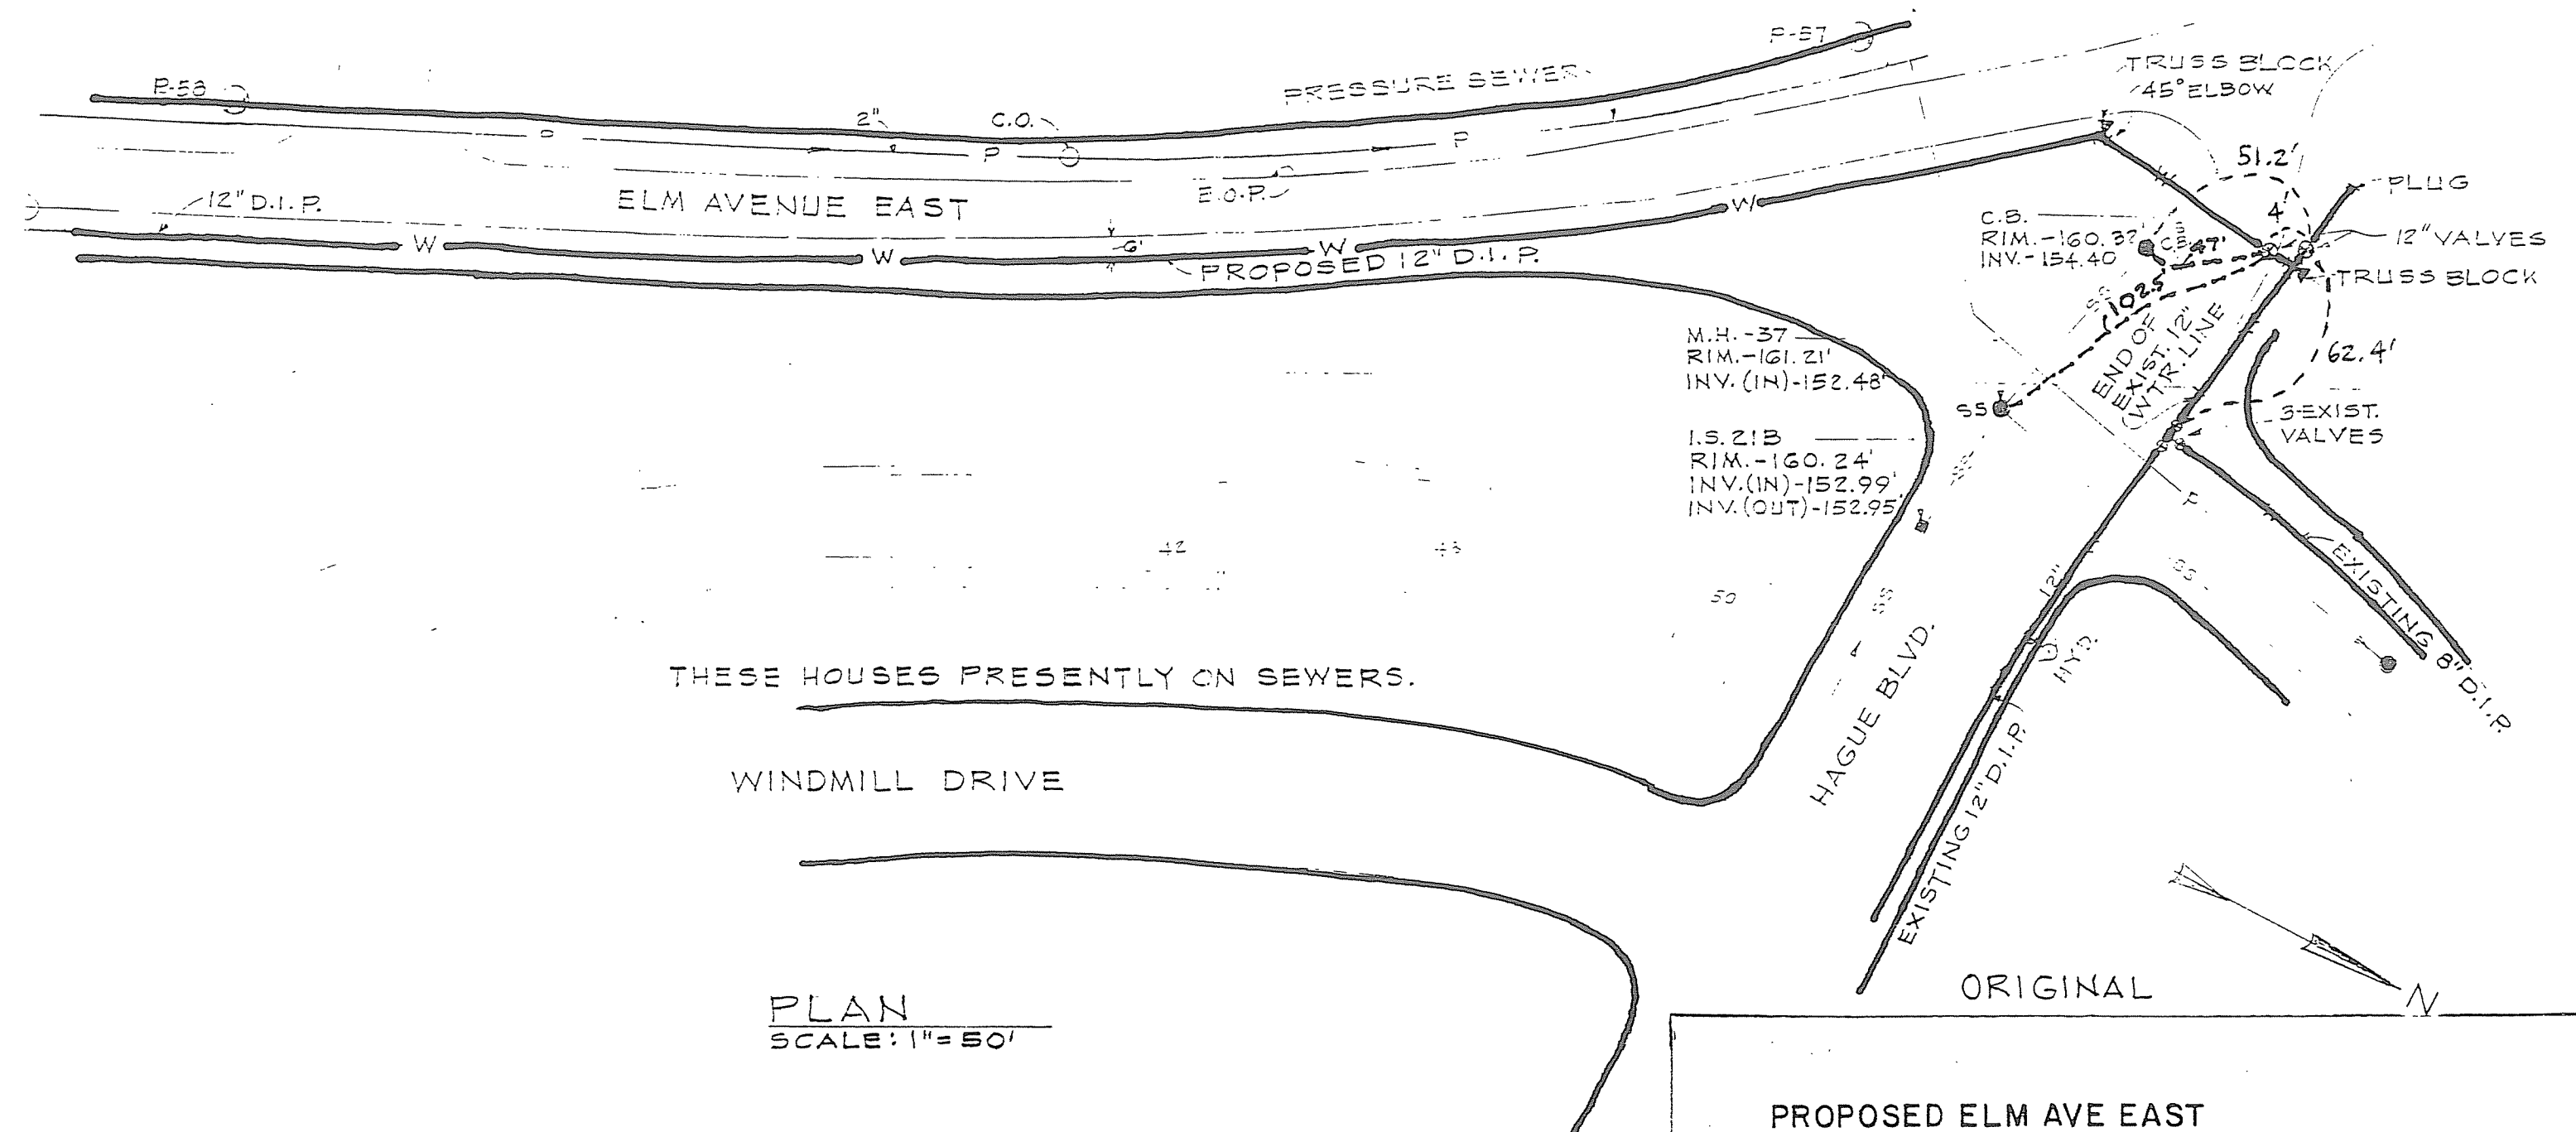

PROPOSED ELM AVE EAST
WATER MAIN EXTENSION
TOWN OF BETHLEHEM

ALBANY COUNTY • NEW YORK
DEPARTMENT OF PUBLIC WORKS
445 DELAWARE AVENUE
DELMAR, NEW YORK 12054

DATE: MAY 17, 1995

