


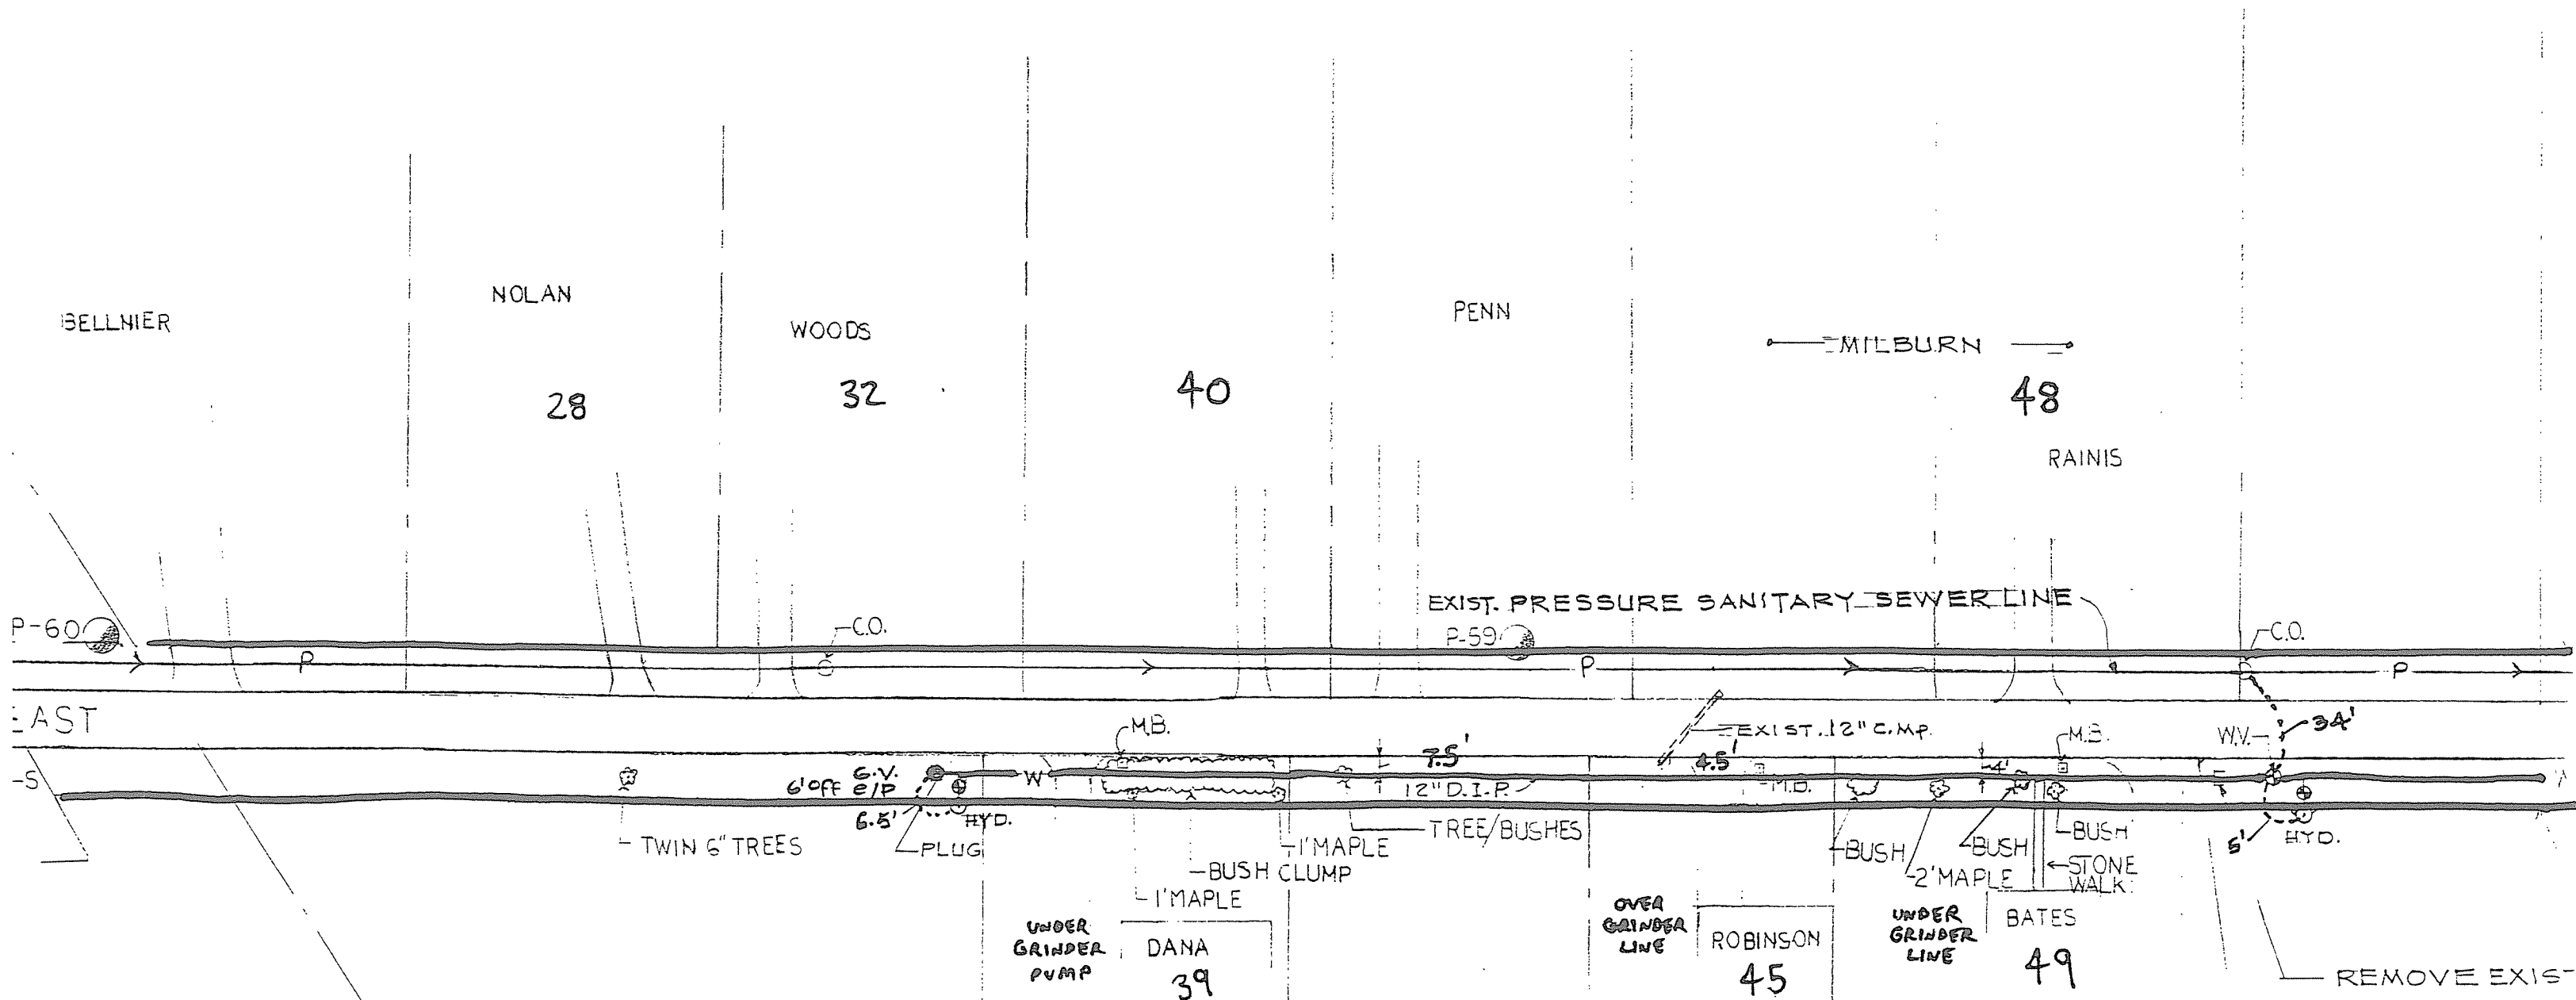

NIAGARA MOHAWK

ELM AVE EAST
 SCALE: 1"=50'
 DATE: 12 AUG 96
 SEE: TB 47, PG 21

ORIGINAL

COUNTY ALBANY	TITLE PROPOSED ELM AVE EAST WATER MAIN EXTENSION	SCALE AS NOTED
STATE NEW YORK		DATE AUG. 22, 1996
DRAWING NO.	 TOWN OF BETHLEHEM ENGINEERING DEPARTMENT 445 Delaware Ave. Delmar, New York 12054	REVISION DATE