


48

MILBURN
JOHN &
LORNA

TOWN HIGHWAY GAR

74

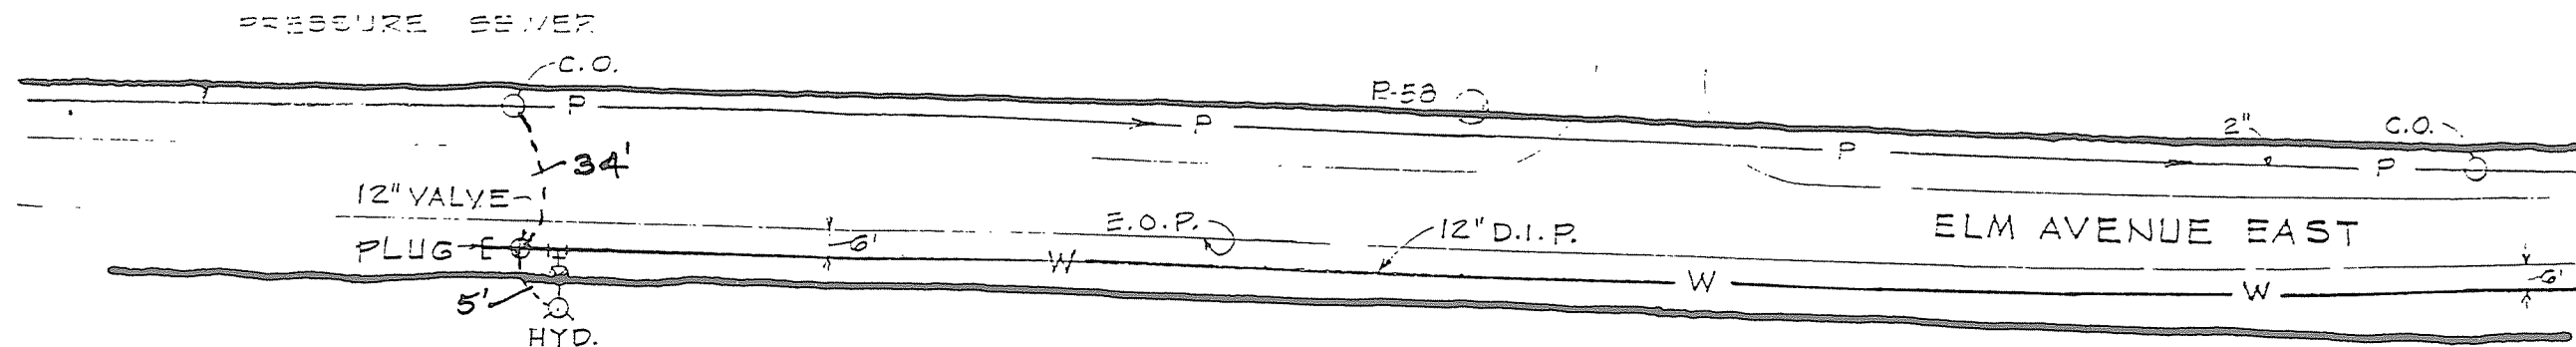

BATES

49

THESE HOUSES PRESENTLY

WINDMILL DRIVE

ORIGINAL

PROPOSED ELM AVE EAST
WATER MAIN EXTENSION
TOWN OF BETHLEHEM

ALBANY COUNTY • NEW YORK

DEPARTMENT OF PUBLIC WORKS

445 DELAWARE AVENUE
DELMAR, NEW YORK 12054

DATE: MAY 17, 1995



PLAN
SCALE: 1" = 50'