


- CATCH BASIN
- MANHOLE
- HYDRANT
- GATE VALVE
- TEE
- THRUST BLOCK
- WATER MAIN

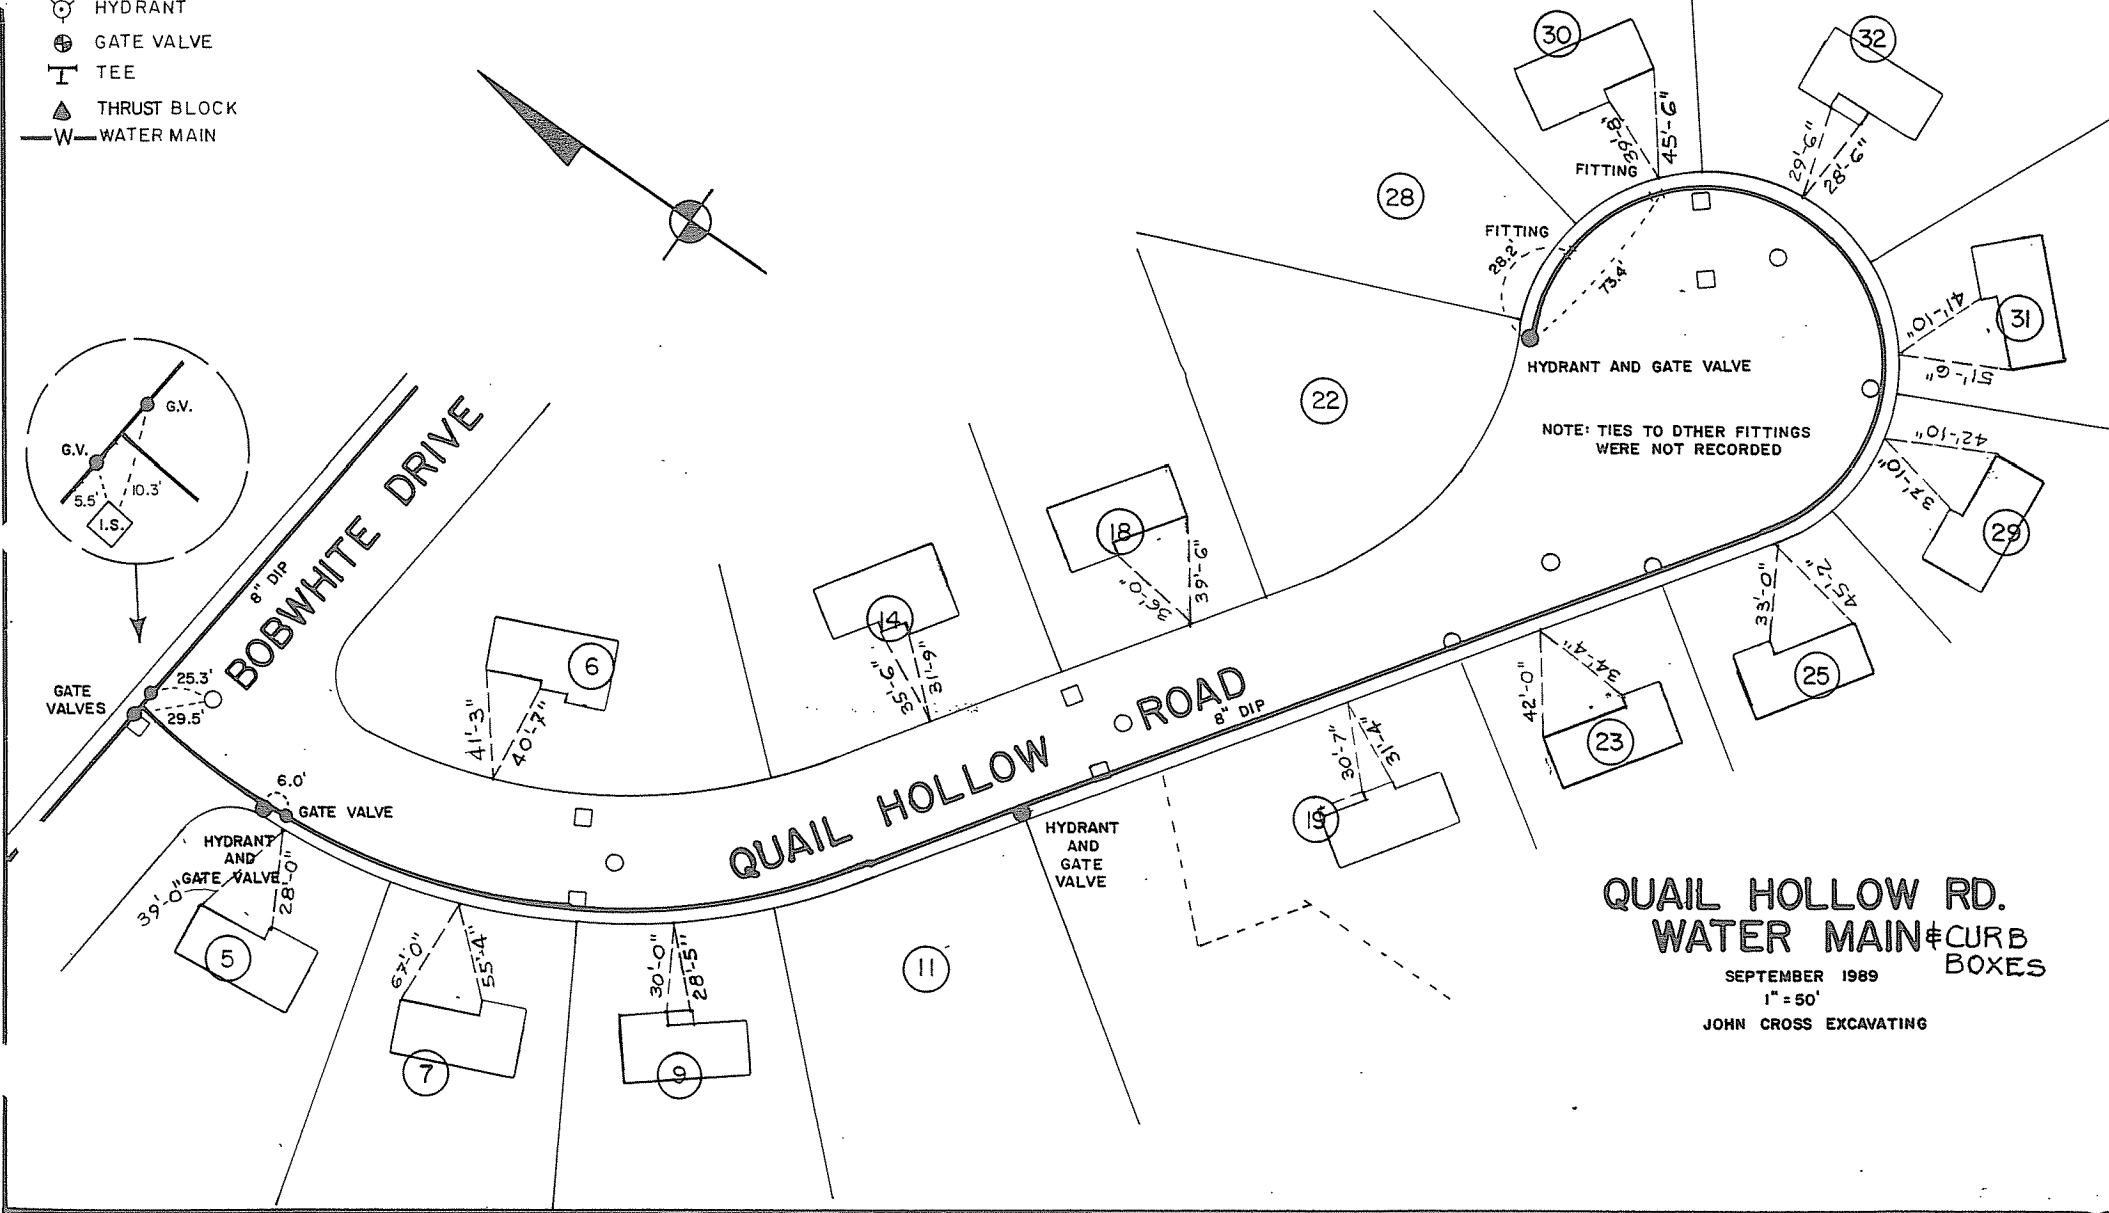

QUAIL HOLLOW RD.
WATER MAIN & CURB
BOXES

SEPTEMBER 1989

 $1'' \approx 50'$

JOHN CROSS EXCAVATING

Quail Hollow