


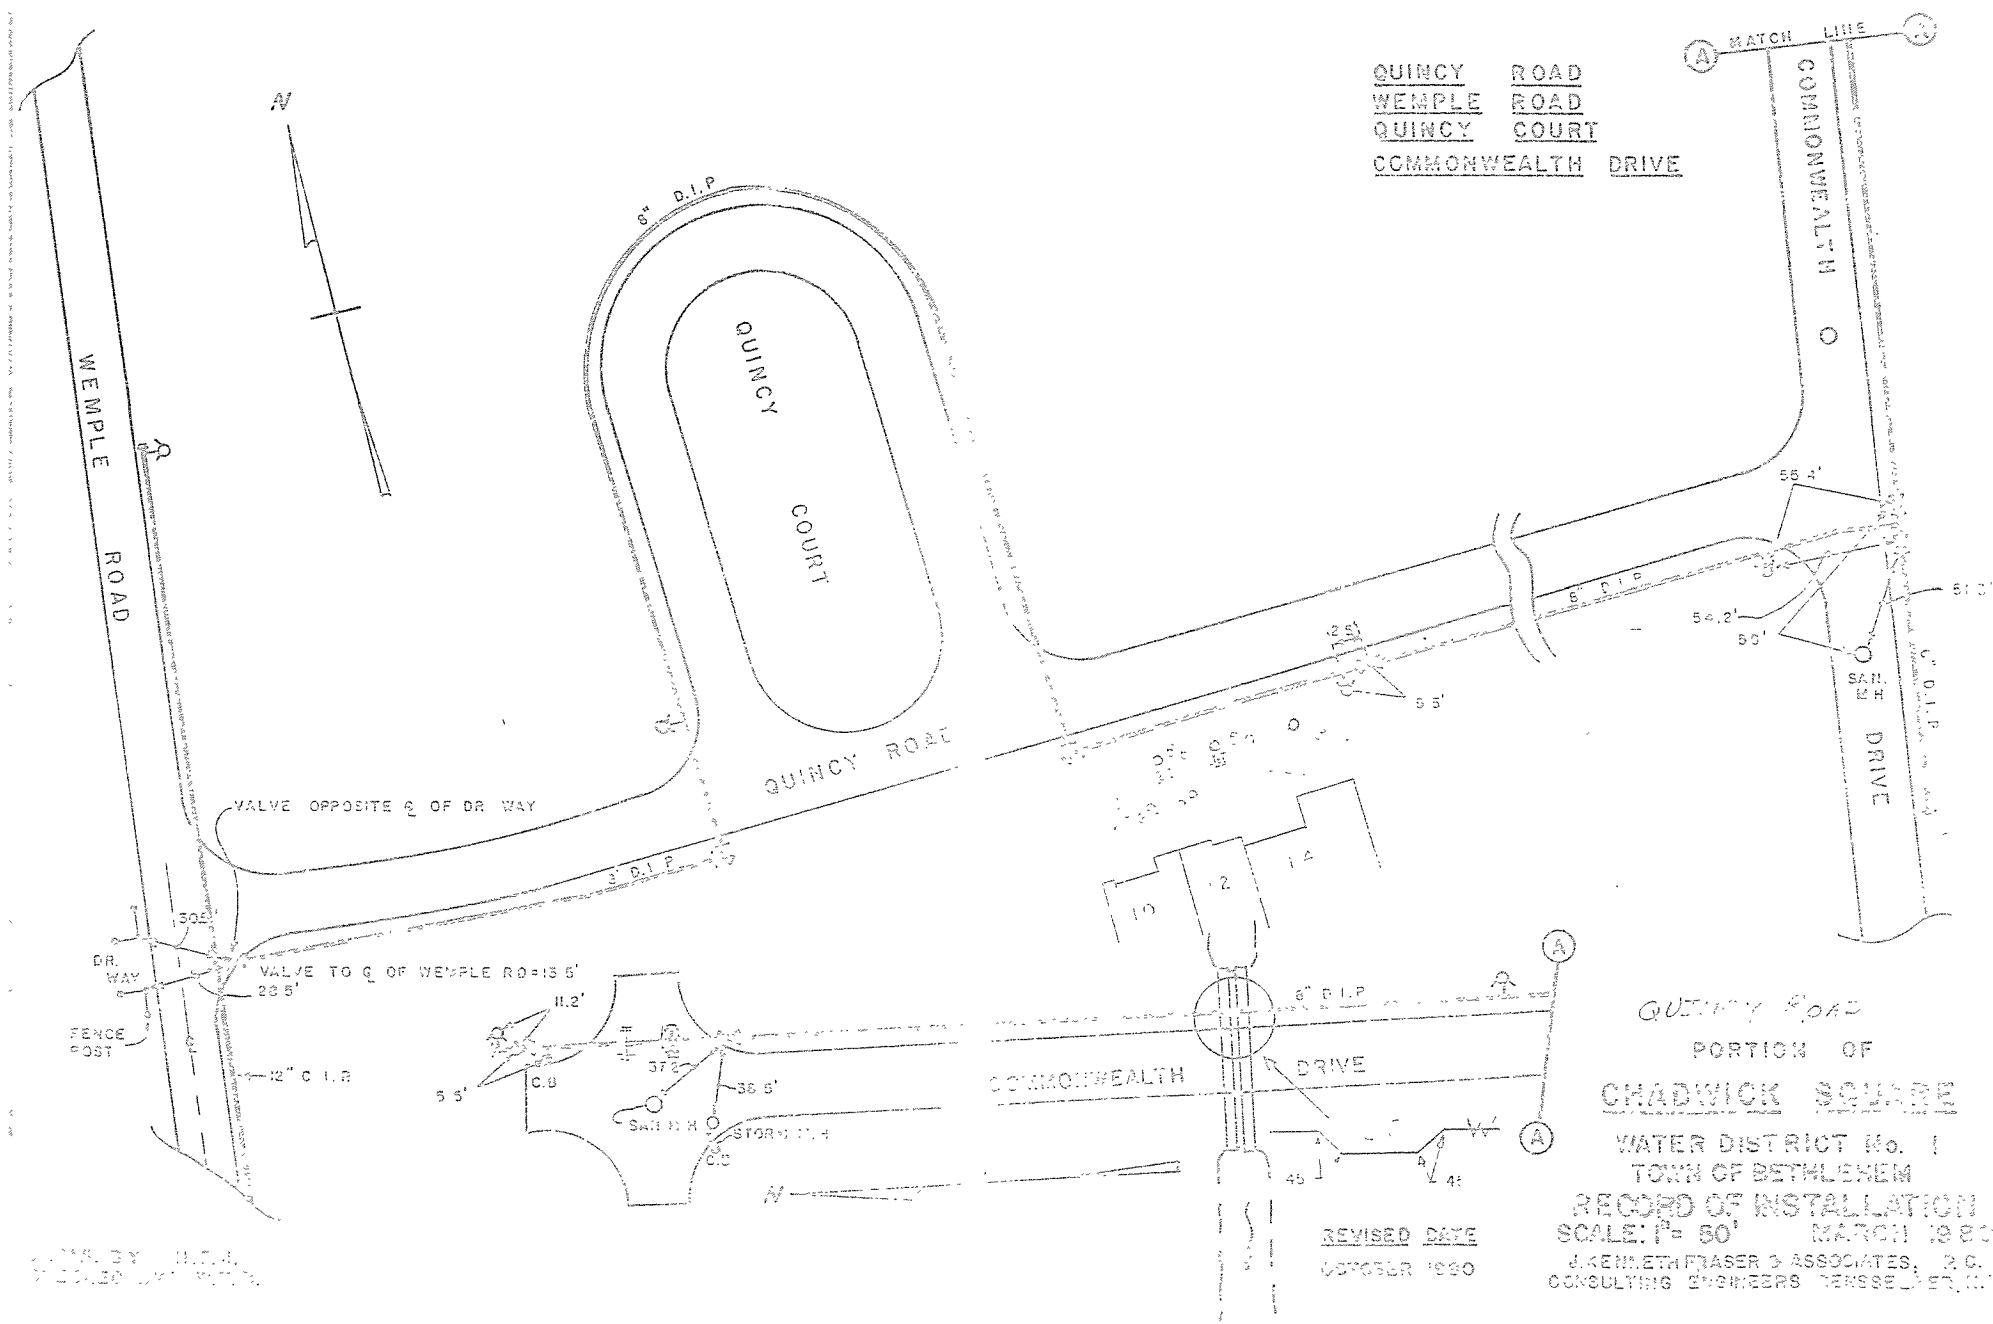

QUINCY ROAD
 WEMPLE ROAD
 QUINCY COURT
 COMMONWEALTH DRIVE

QUINCY ROAD
 PORTION OF
 CHADWICK SQUARE

WATER DISTRICT No. 1
 TOWN OF BETHLEHEM
 RECORD OF INSTALLATION
 SCALE: 1" = 50' MARCH 1980
 J. KENNETH FRASER & ASSOCIATES, P.C.
 CONSULTING ENGINEERS BETHLEHEM, PA.

REVISED DATE
 OCTOBER 1980

DESIGNED BY: J.E.H.
 CHECKED BY: J.E.H.