


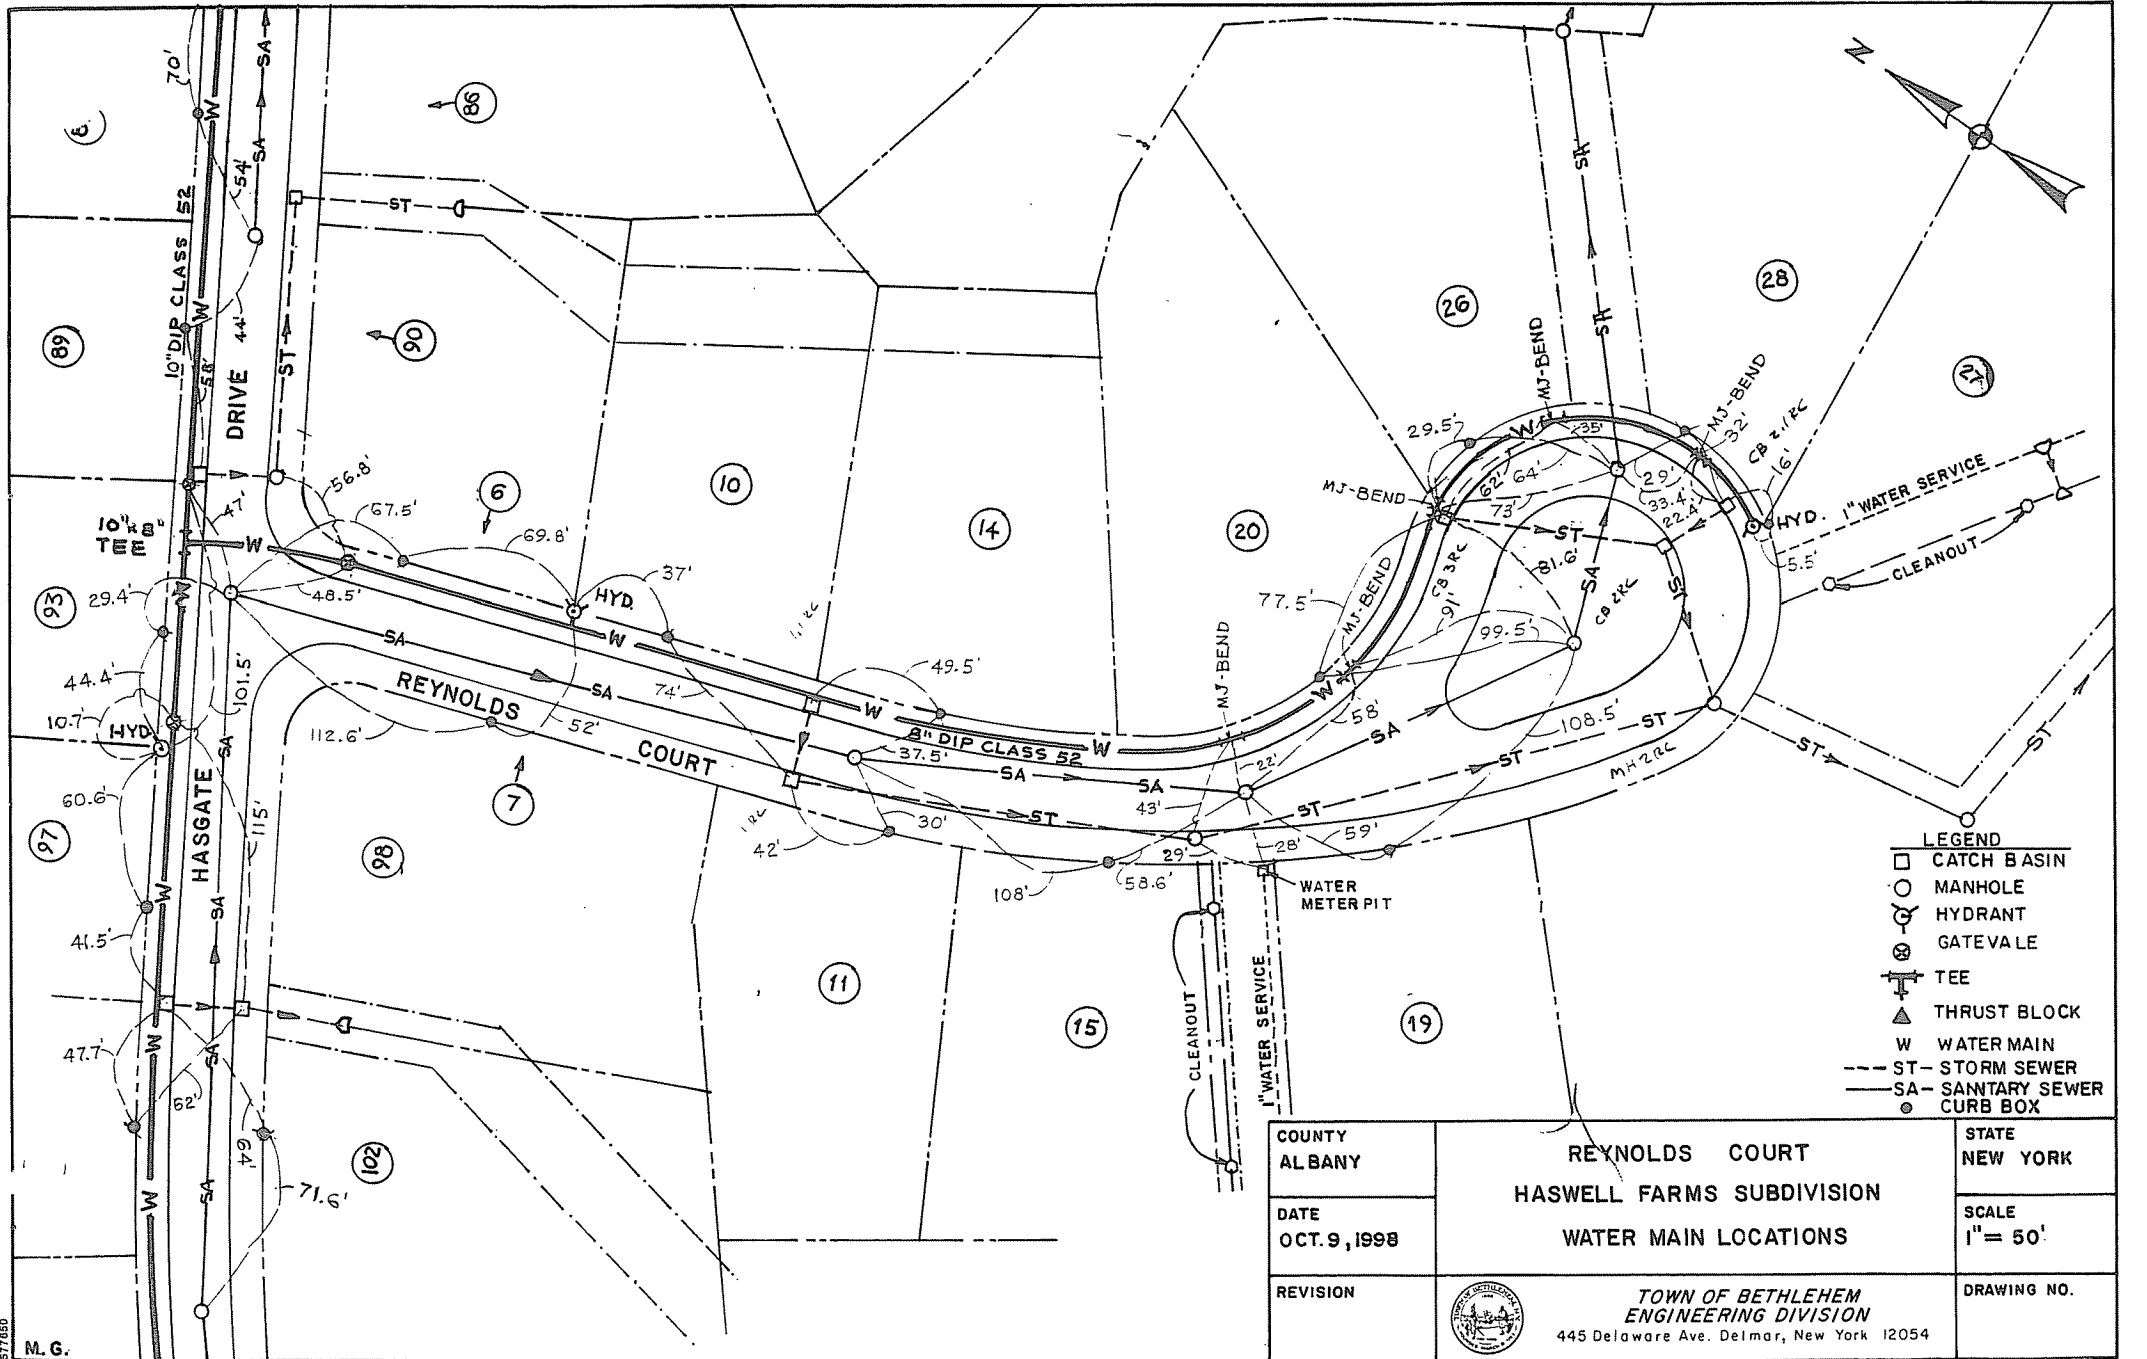

- LEGEND**
- CATCH BASIN
 - MANHOLE
 - ⊕ HYDRANT
 - ⊗ GATEVALE
 - ⊥ TEE
 - ▲ THRUST BLOCK
 - W WATER MAIN
 - - - ST- STORM SEWER
 - - - SA- SANITARY SEWER
 - CURB BOX

COUNTY ALBANY	REYNOLDS COURT HASWELL FARMS SUBDIVISION WATER MAIN LOCATIONS	STATE NEW YORK
DATE OCT. 9, 1998		SCALE 1" = 50'
REVISION	 TOWN OF BETHLEHEM ENGINEERING DIVISION 445 Delaware Ave. Delmar, New York 12054	DRAWING NO.

HASWELL FARMS PH IV