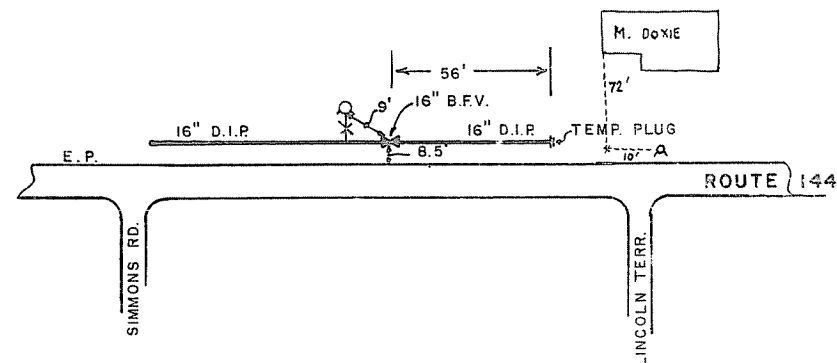
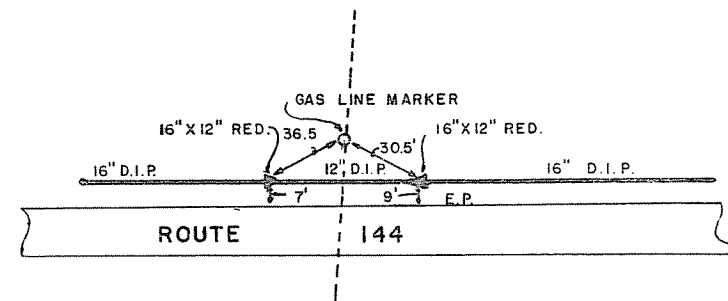
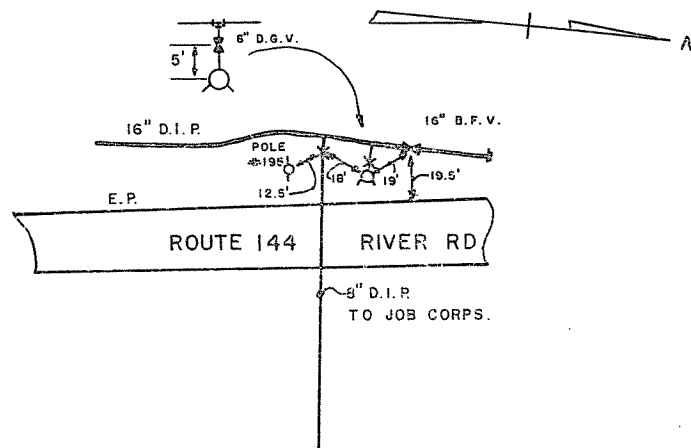


ATE 144
 RIVER ROAD
 WATER DISTRICT NO. 1
 TOWN OF BETHLEHEM
RECORD OF INSTALLATIONS
 J. KENNETH FRASER & ASSOCIATES, P.C.
 CONSULTING ENGRS. RENSSELAER, N.Y.
 SCALE 1"=50' AUGUST 1979

Dwn. by H.P.J.
 Chk. by W.T.B.