
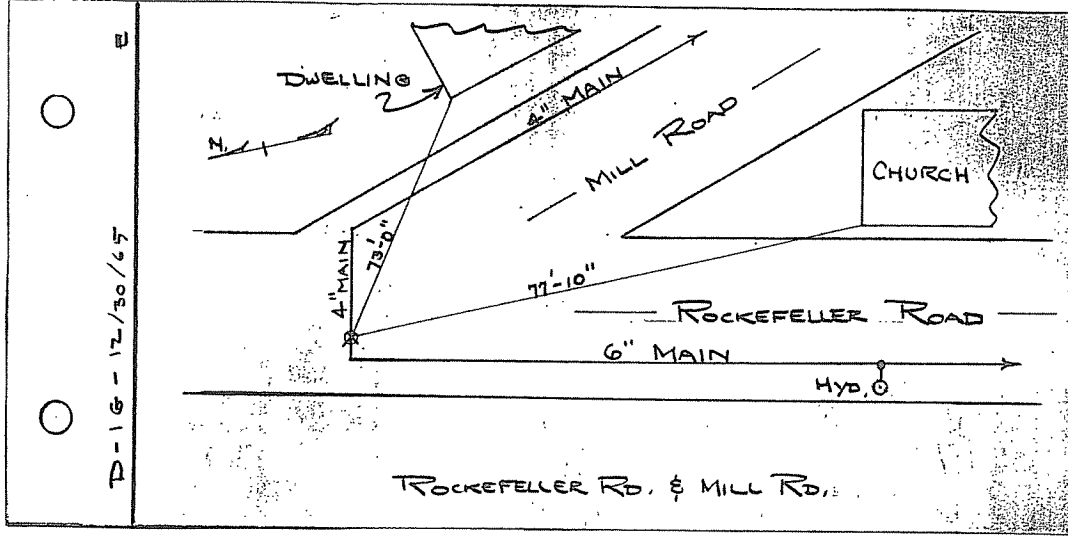


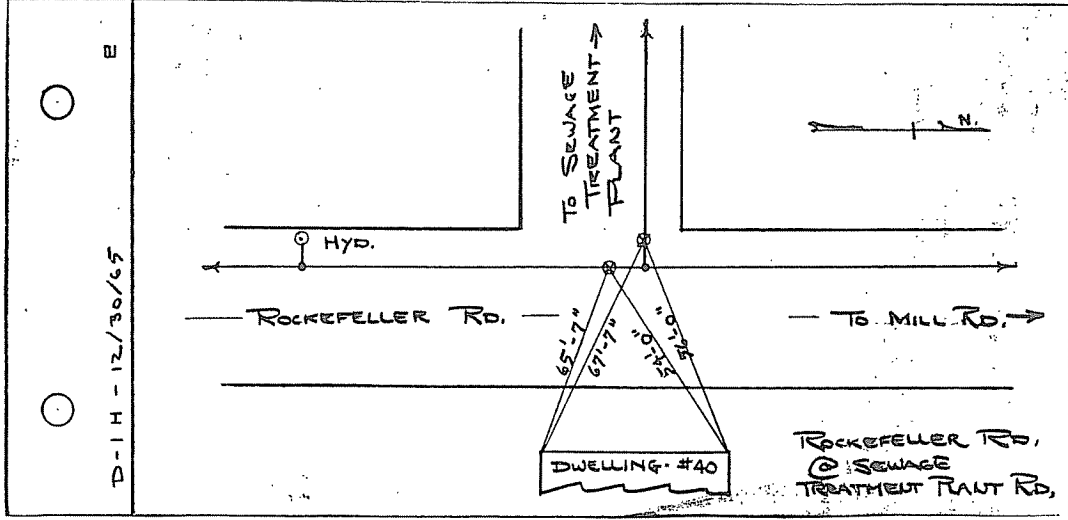

ROCKEFELLER ROAD
WATER MAIN