



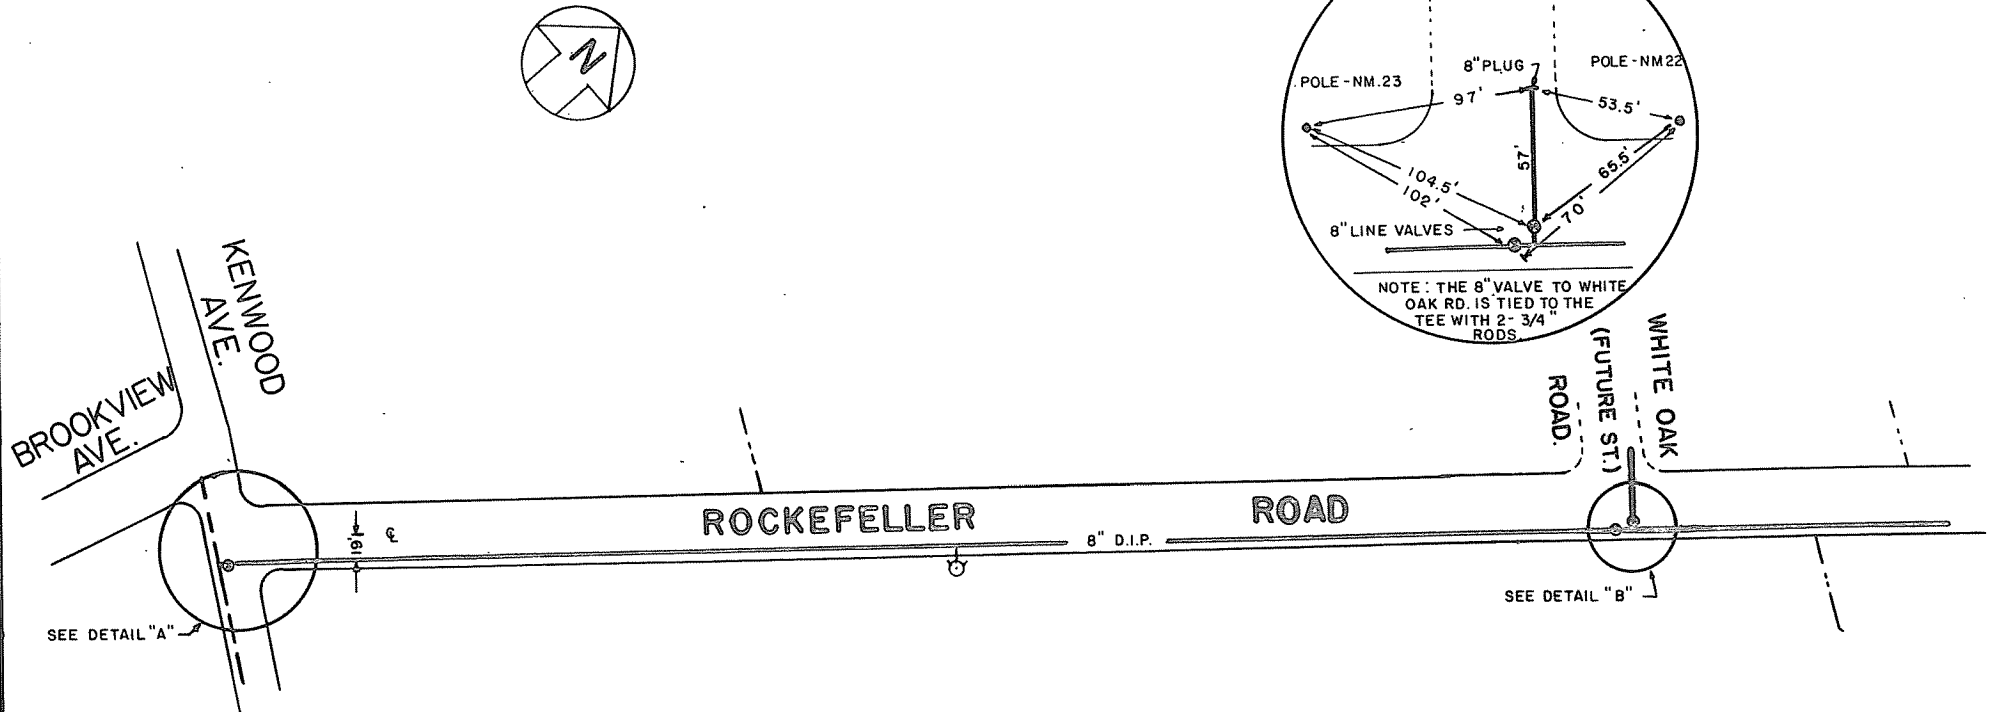


DETAIL "A"
N.T.S.

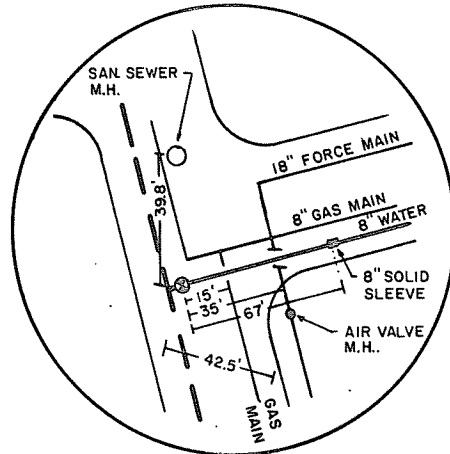

NOTE: WATER MAIN IS 0.80' BELOW GAS MAIN AND 1.5' ABOVE THE FORCE MAIN.

DETAIL "B"
N.T.S.

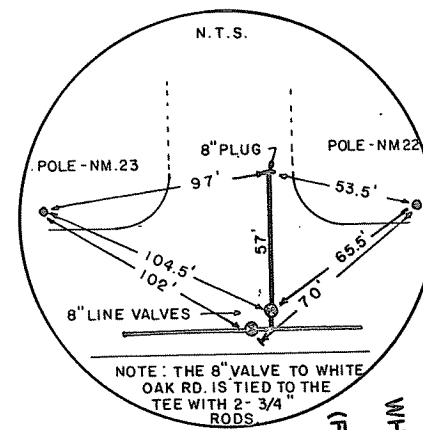

NOTE: THE 8" VALVE TO WHITE OAK RD. IS TIED TO THE TEE WITH 2- 3/4" RODS

ROCKEFELLER RD. (DELWOOD ACRES)

RECORD OF INSTALLATION TOWN OF BETHLEHEM WATER DISTRICT NO. 1

CONTRACTOR: MICHELI.
DWN. BY: CW

NOVEMBER 1965
SCALE 1"=100'