
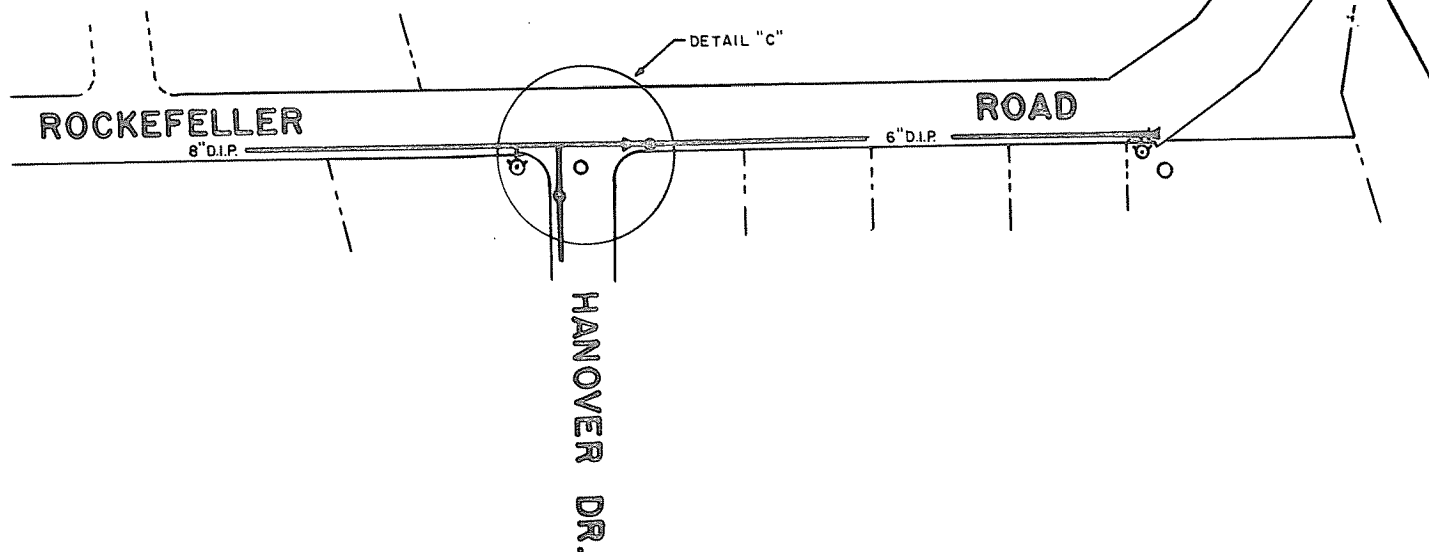
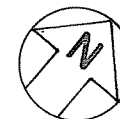


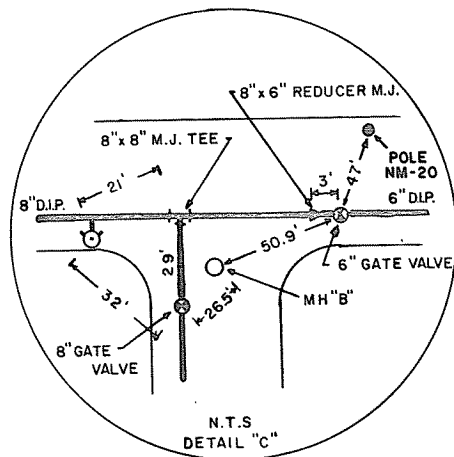

ROCKEFELLER RD.
 (DELWOOD ACRES)

RECORD OF INSTALLATION.
 TOWN OF BETHLEHEM
 WATER DISTRICT NO. 1

CONTRACTOR - MICHELI
 NOVEMBER 1965
 DWN. BY CW
 SCALE 1"=100'