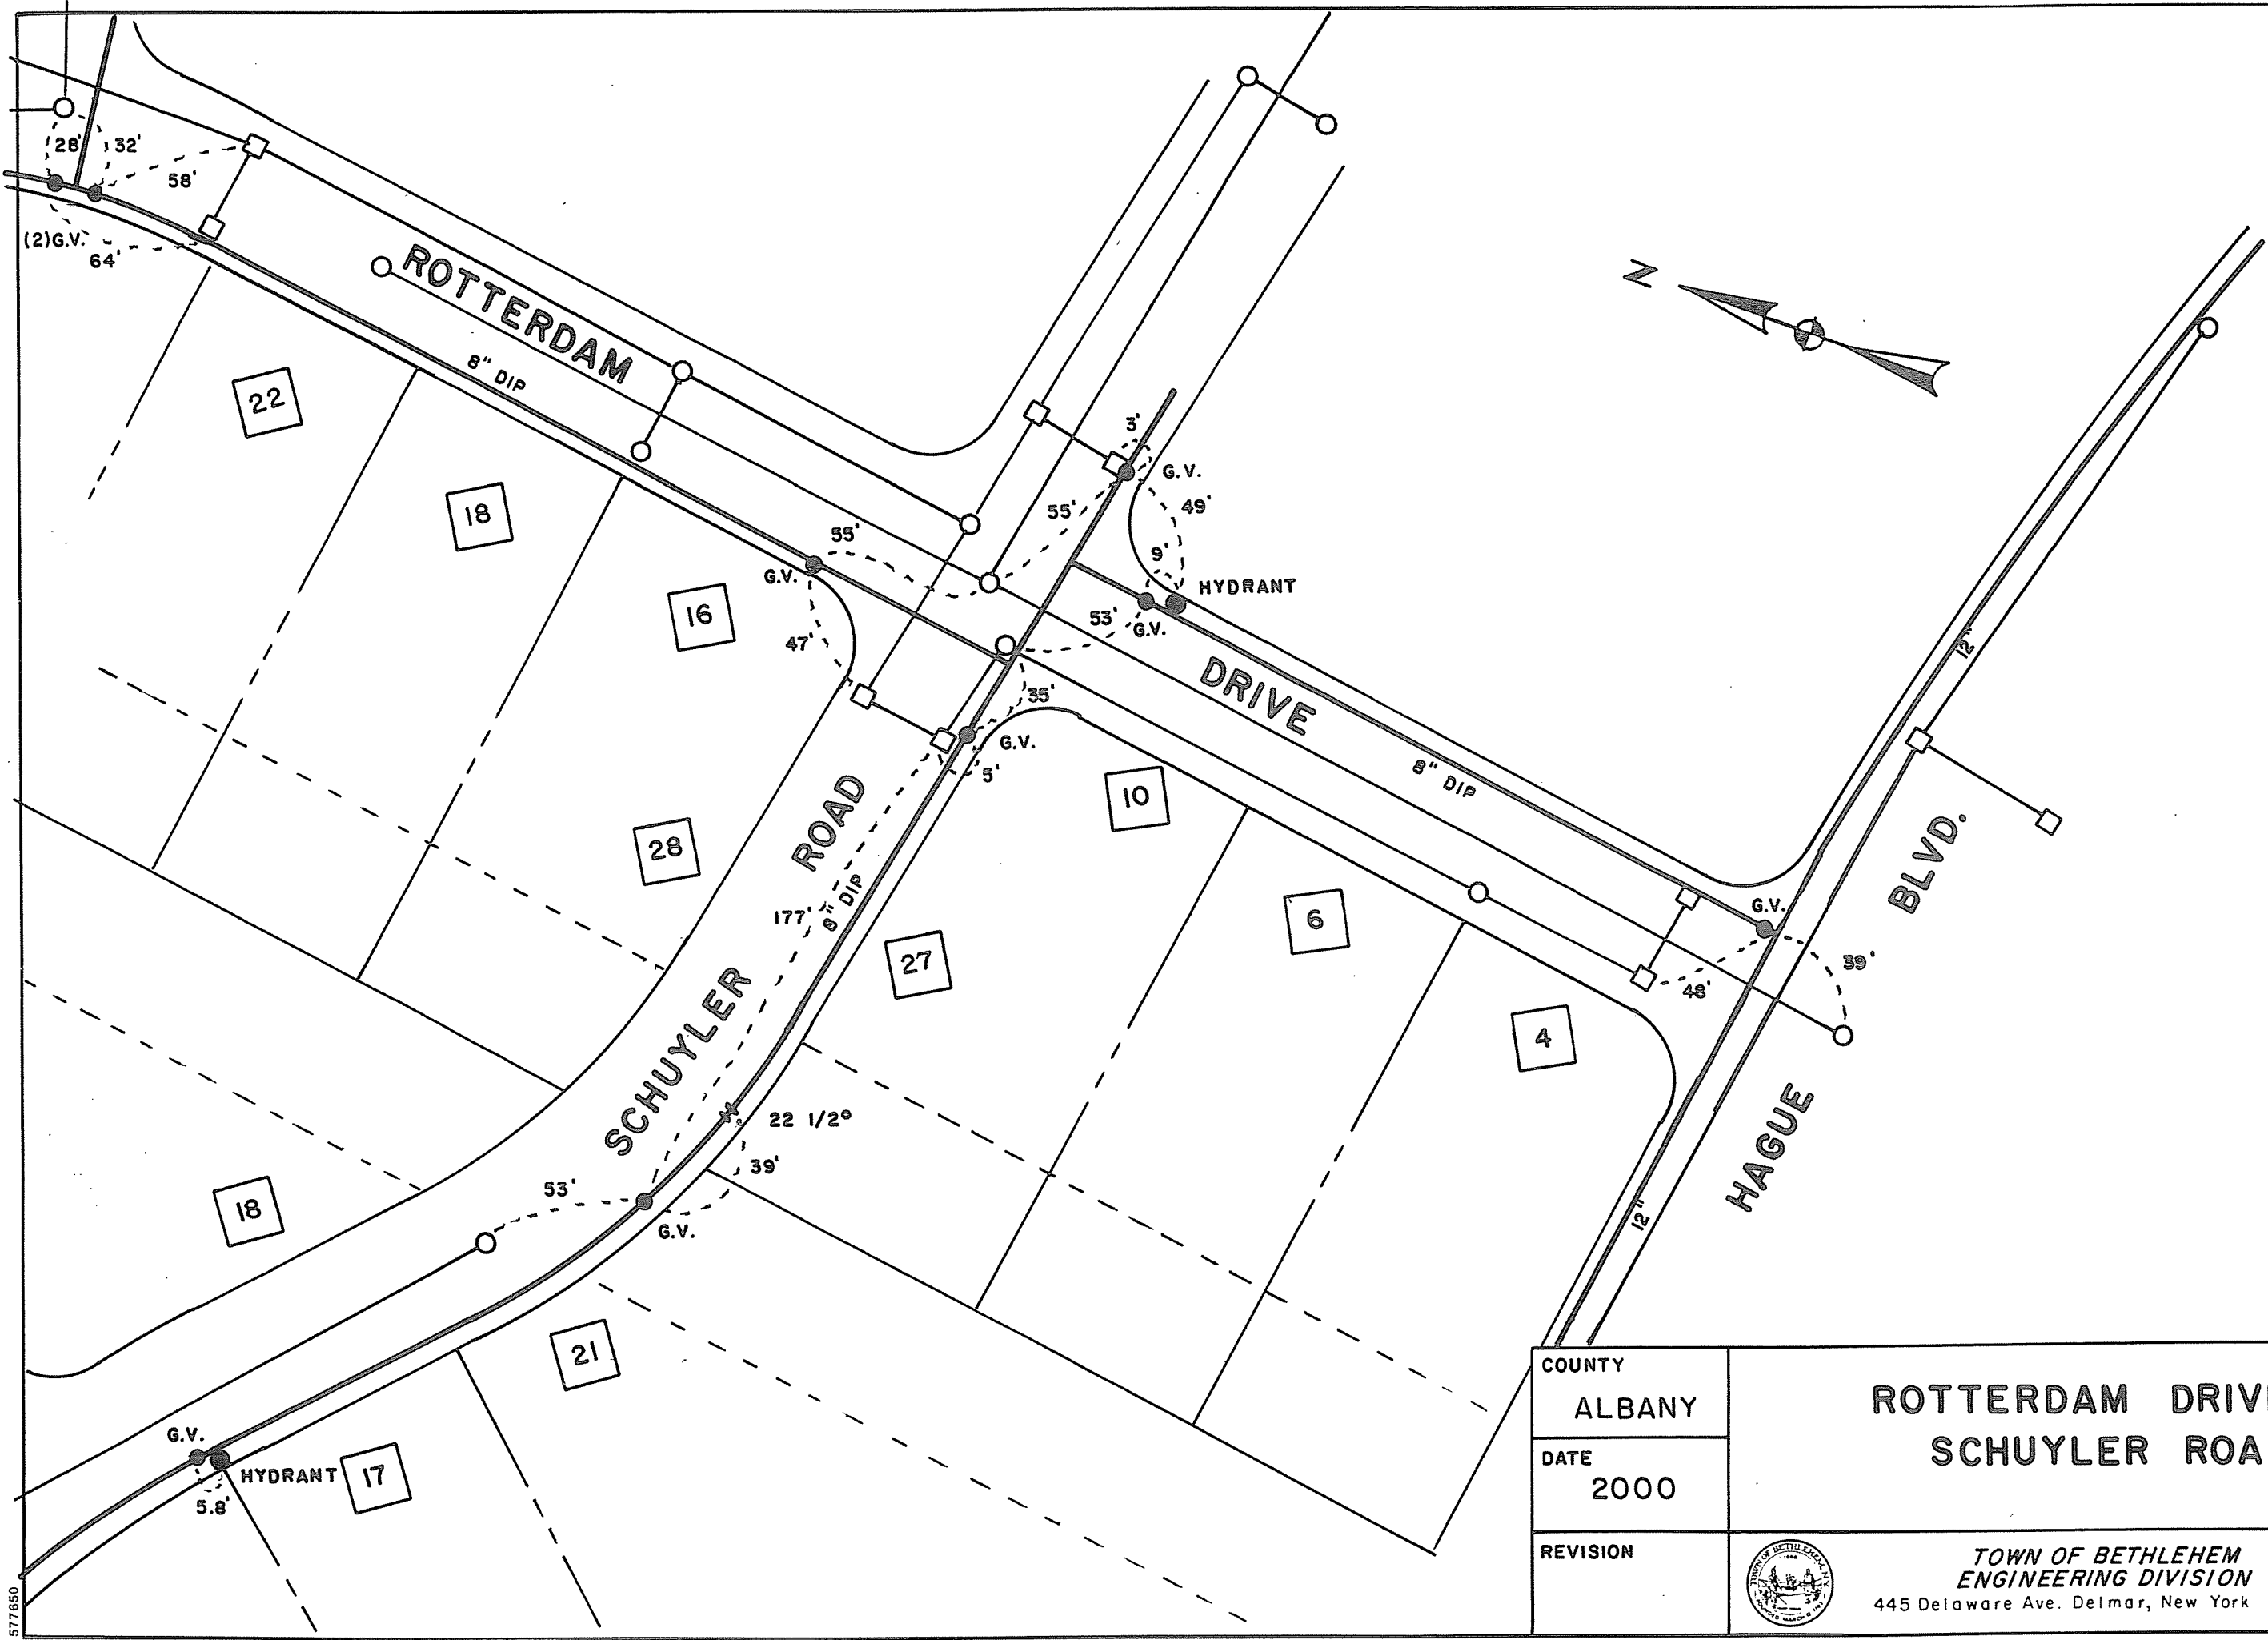


|                  |                                                                                                                                                                                |                   |
|------------------|--------------------------------------------------------------------------------------------------------------------------------------------------------------------------------|-------------------|
| COUNTY<br>ALBANY | ROTTERDAM DRIVE<br>SCHUYLER ROAD                                                                                                                                               | STATE<br>NY       |
| DATE<br>2000     |                                                                                                                                                                                | SCALE<br>1" = 50' |
| REVISION         | <br>TOWN OF BETHLEHEM<br>ENGINEERING DIVISION<br>445 Delaware Ave. Delmar, New York 12054 | DRAWING NO.       |

577650