


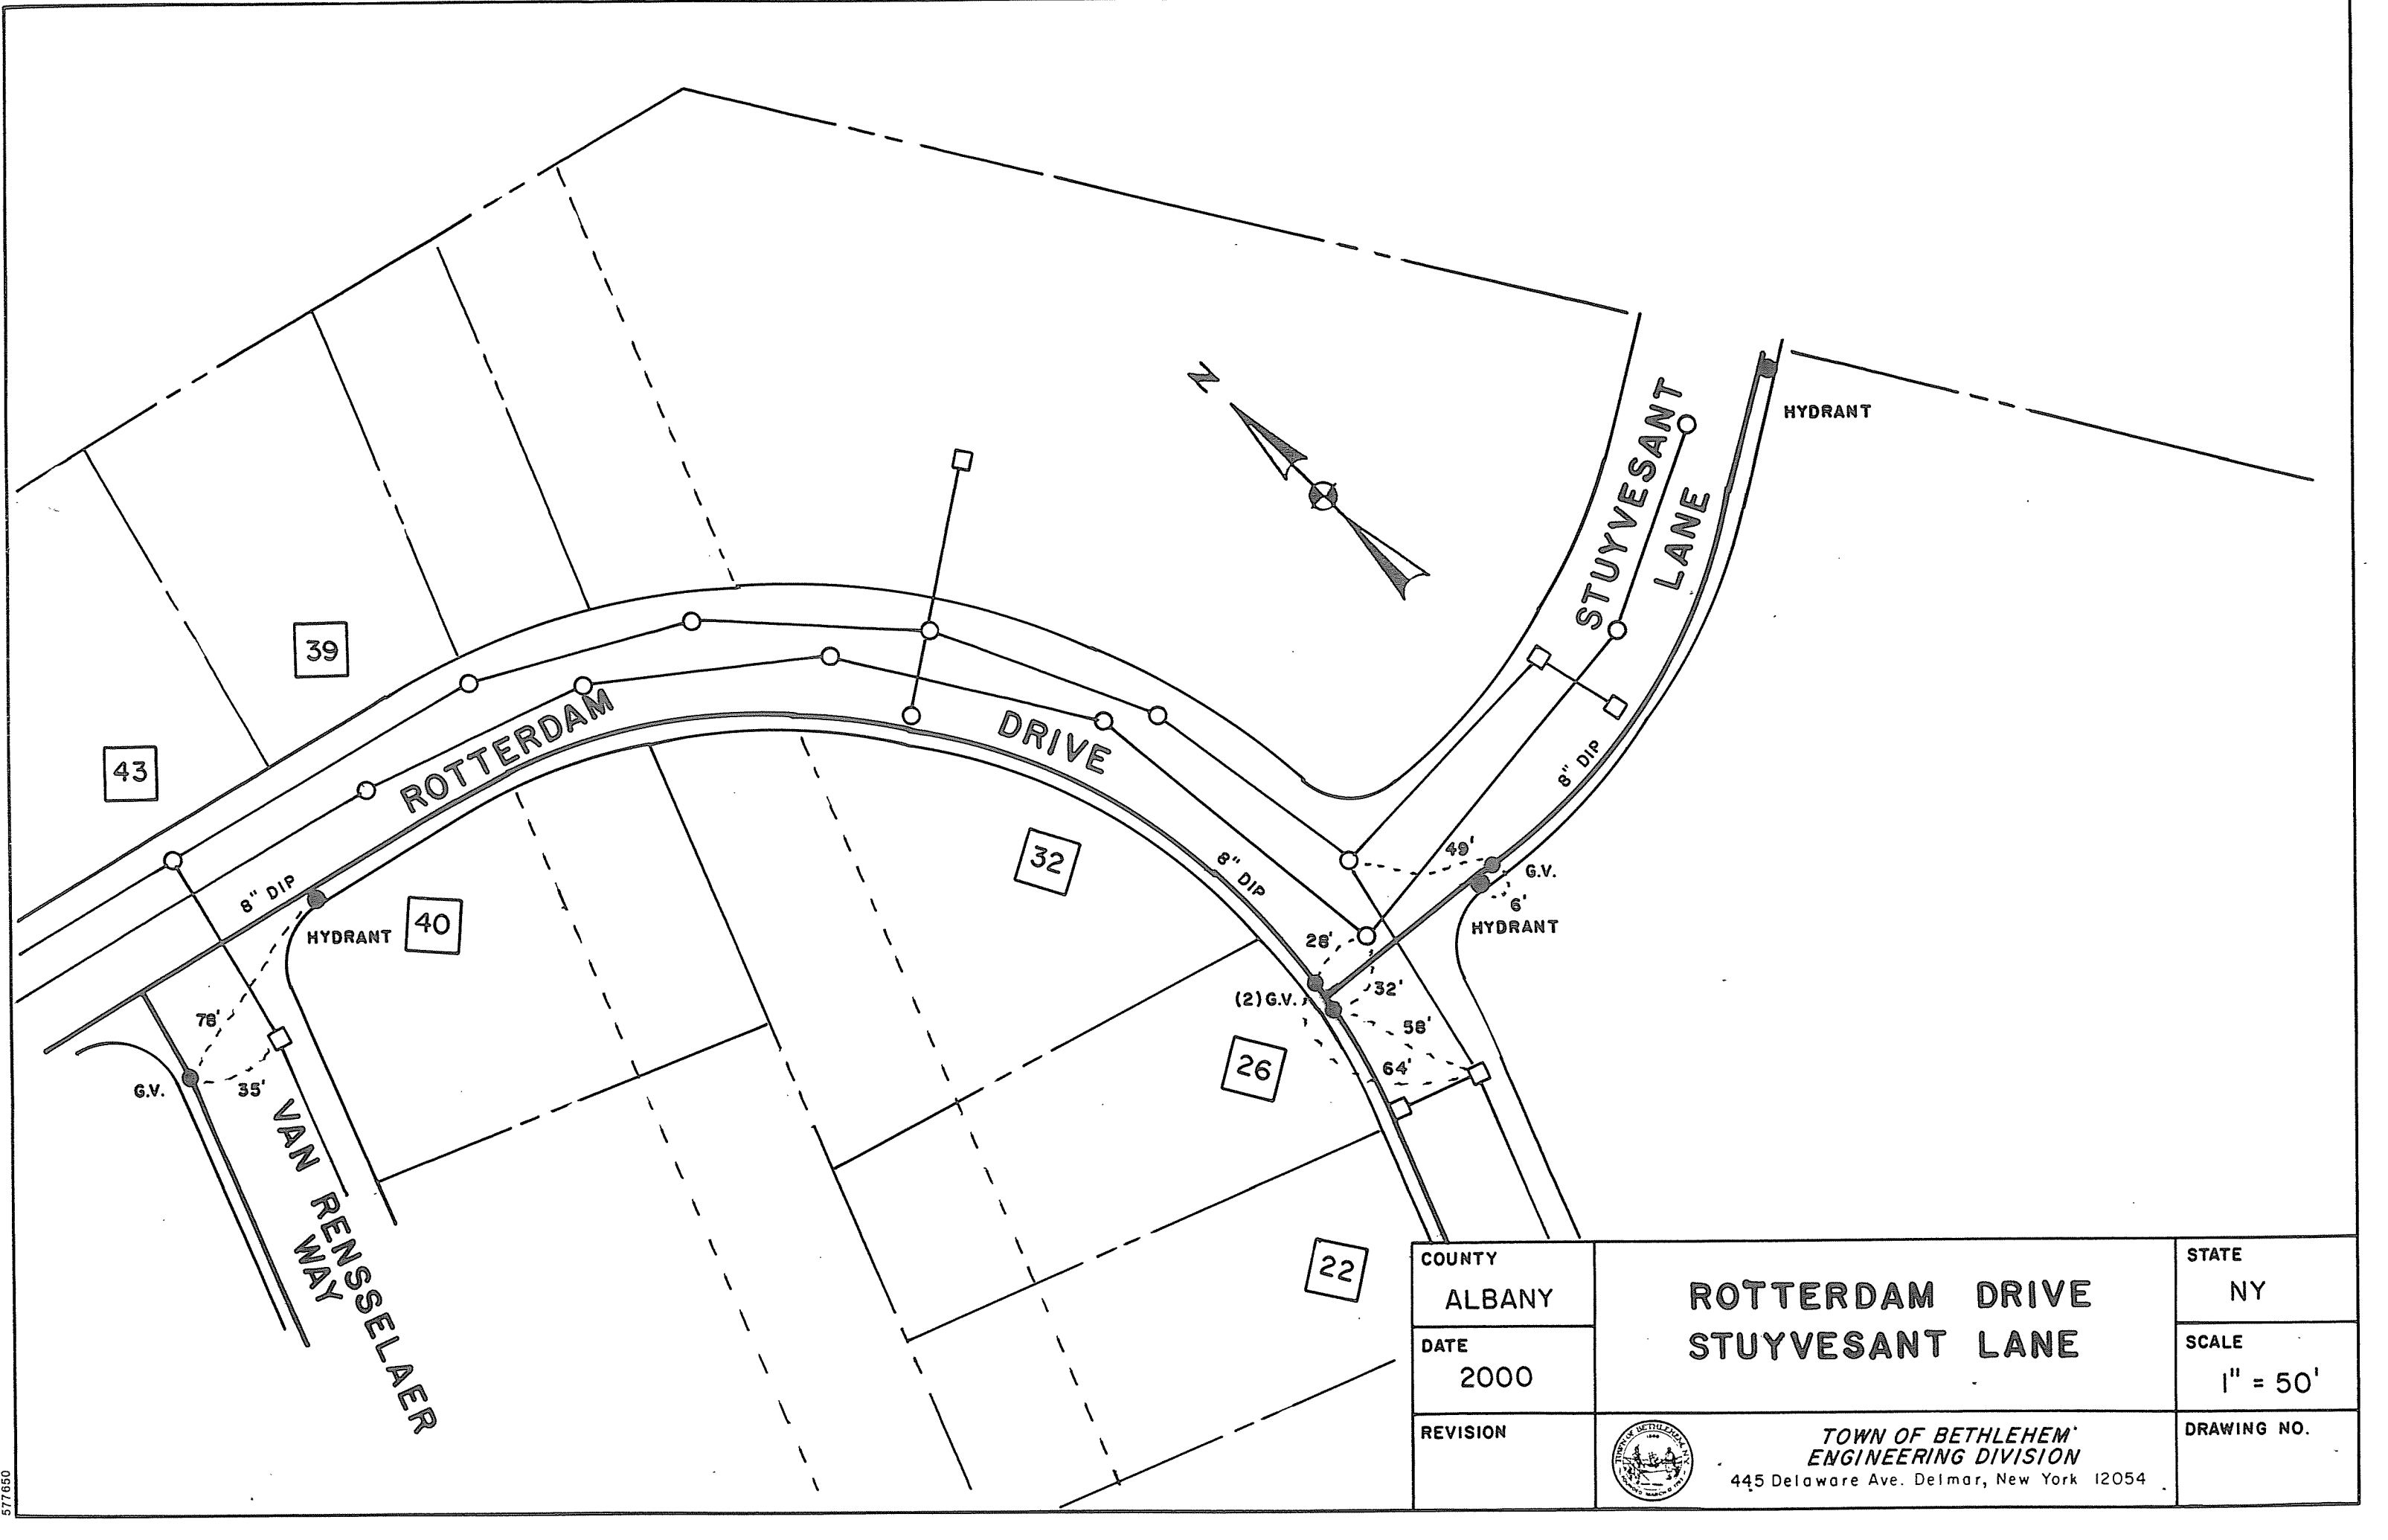

COUNTY	ROTTERDAM DRIVE STUYVESANT LANE	STATE
ALBANY		NY
DATE		SCALE
2000	 TOWN OF BETHLEHEM ENGINEERING DIVISION 445 Delaware Ave. Delmar, New York 12054	1" = 50'
REVISION		DRAWING NO.

577650