


577650

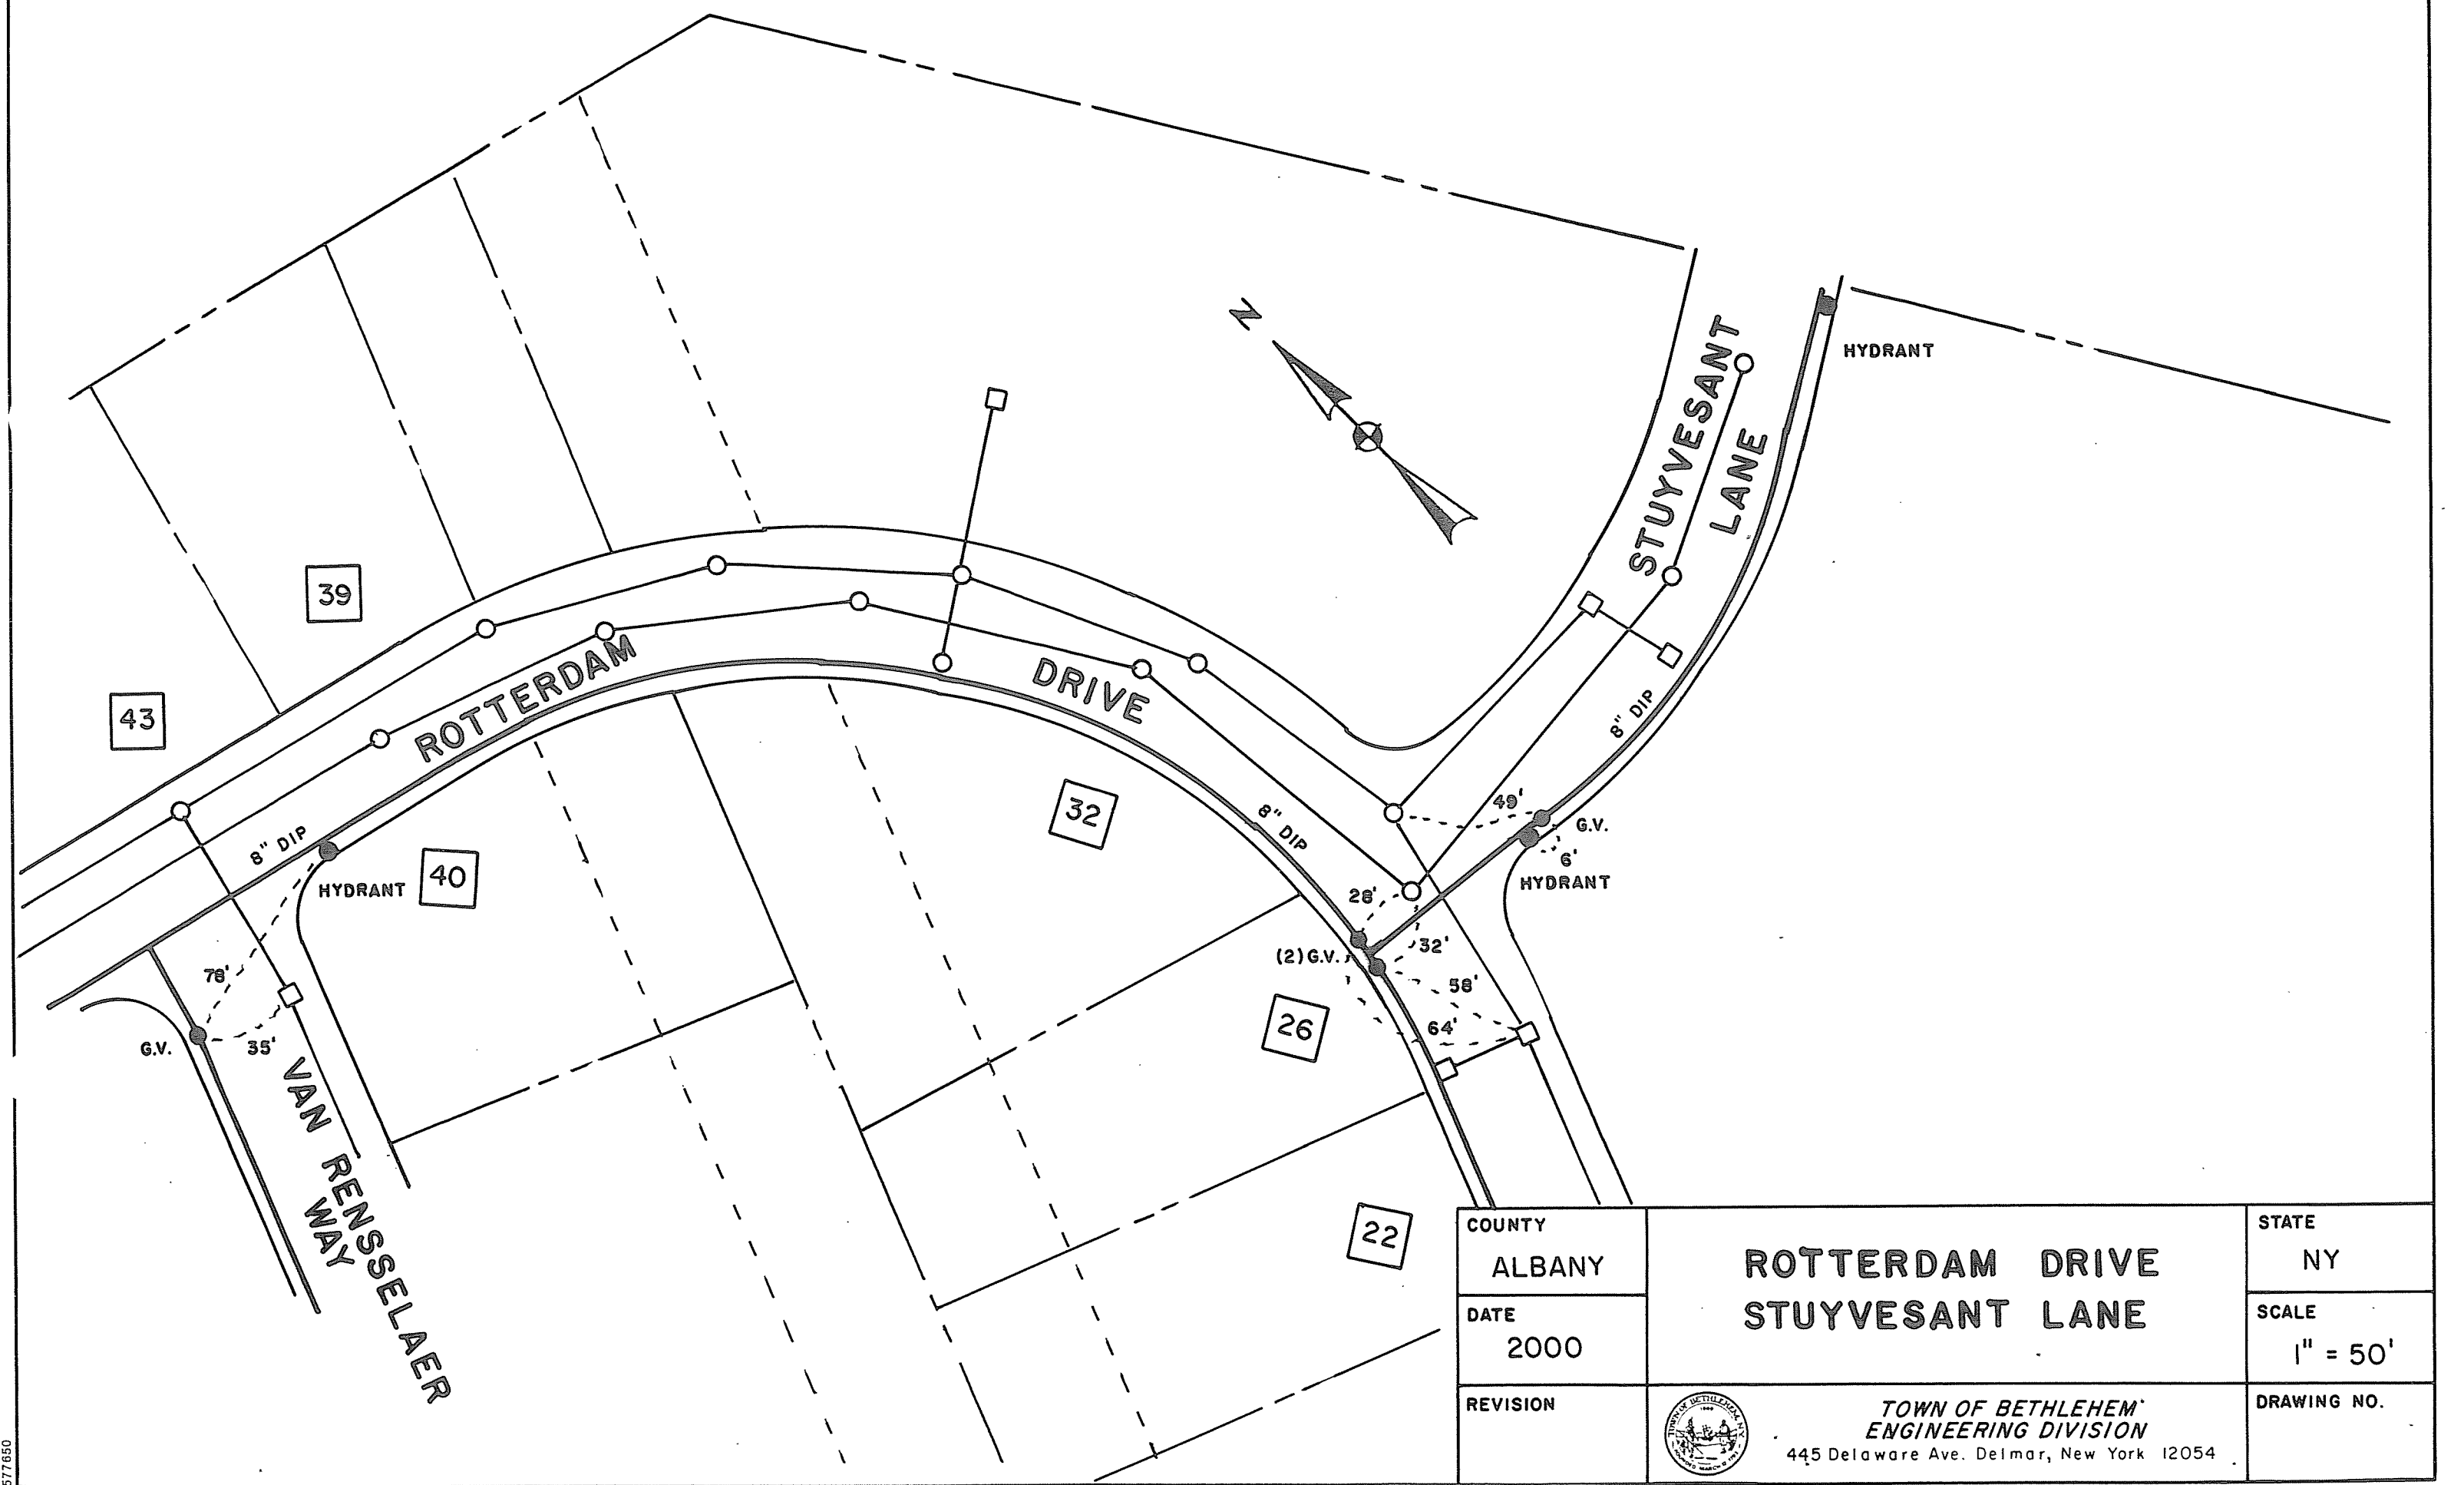

COUNTY ALBANY	ROTTERDAM DRIVE STUYVESANT LANE	STATE NY
DATE 2000		SCALE 1" = 50'
REVISION	 TOWN OF BETHLEHEM ENGINEERING DIVISION 445 Delaware Ave. Delmar, New York 12054	DRAWING NO.