


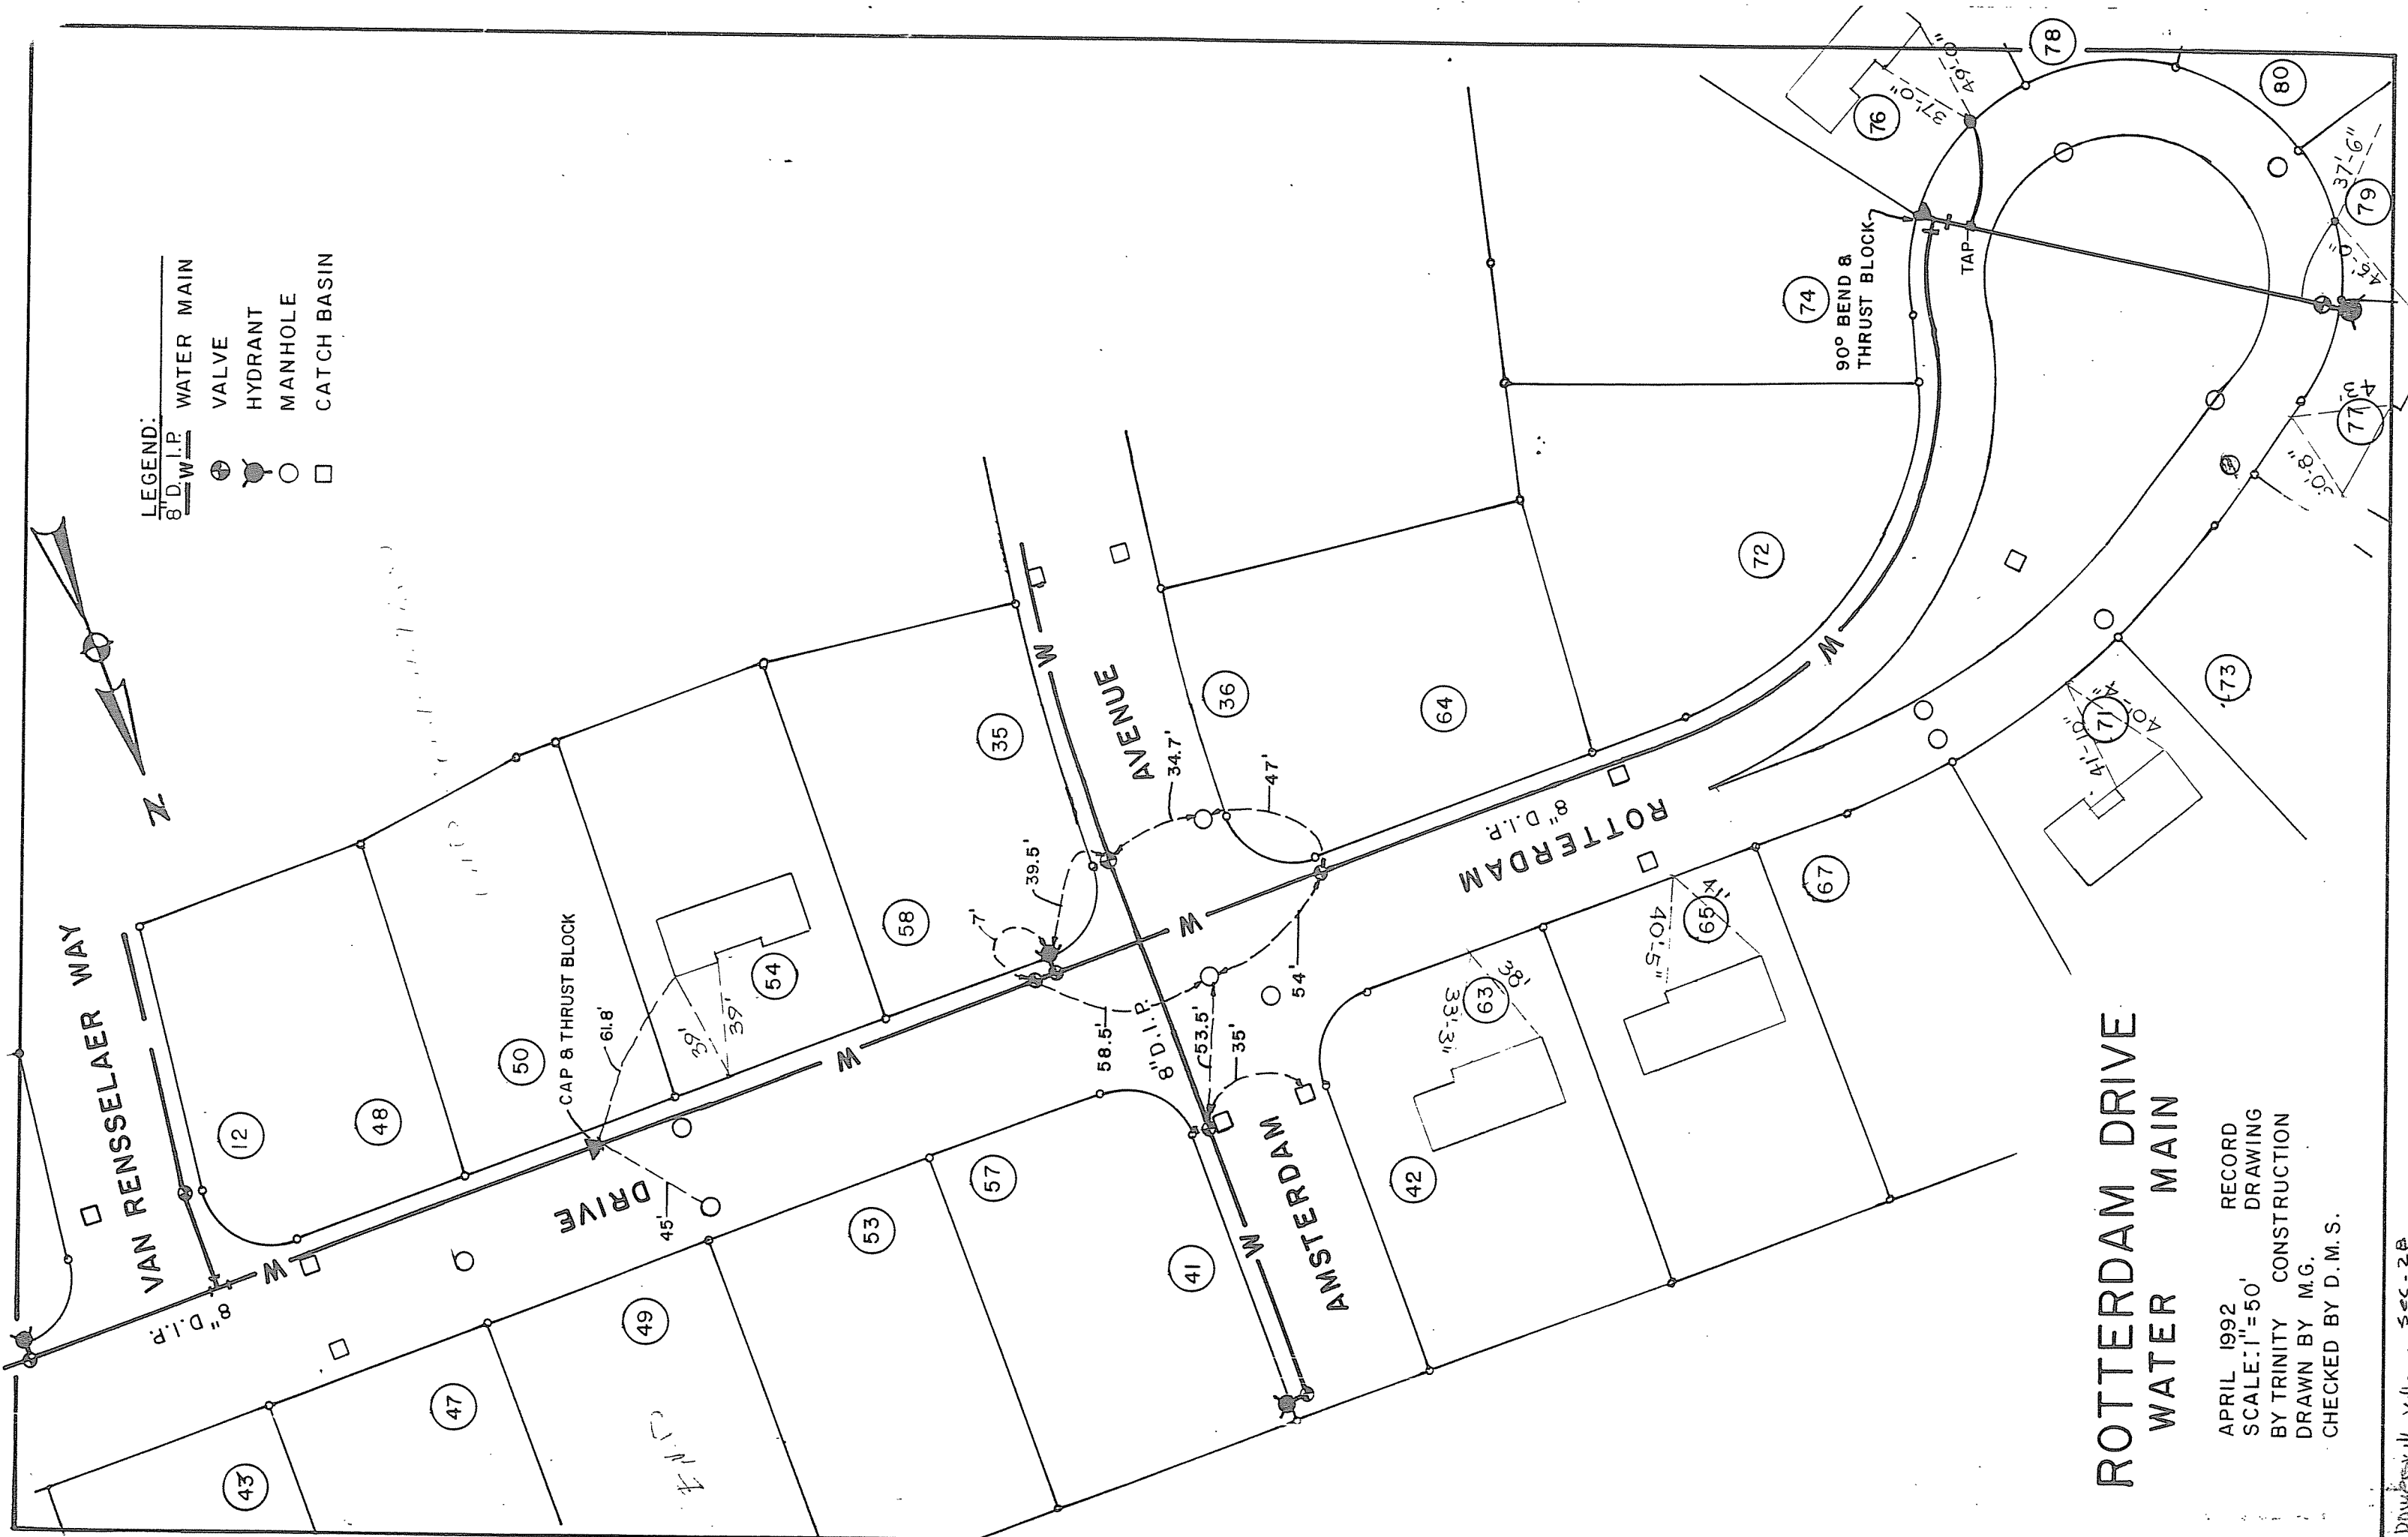

LEGEND:
8" D. I.P. WATER MAIN
VALVE
HYDRANT
MANHOLE
CATCH BASIN

ROTTERDAM DRIVE
WATER MAIN

APRIL 1992 RECORD
SCALE: 1"=50'
DRAWING
BY TRINITY CONSTRUCTION
DRAWN BY M.G.
CHECKED BY D.M.S.