


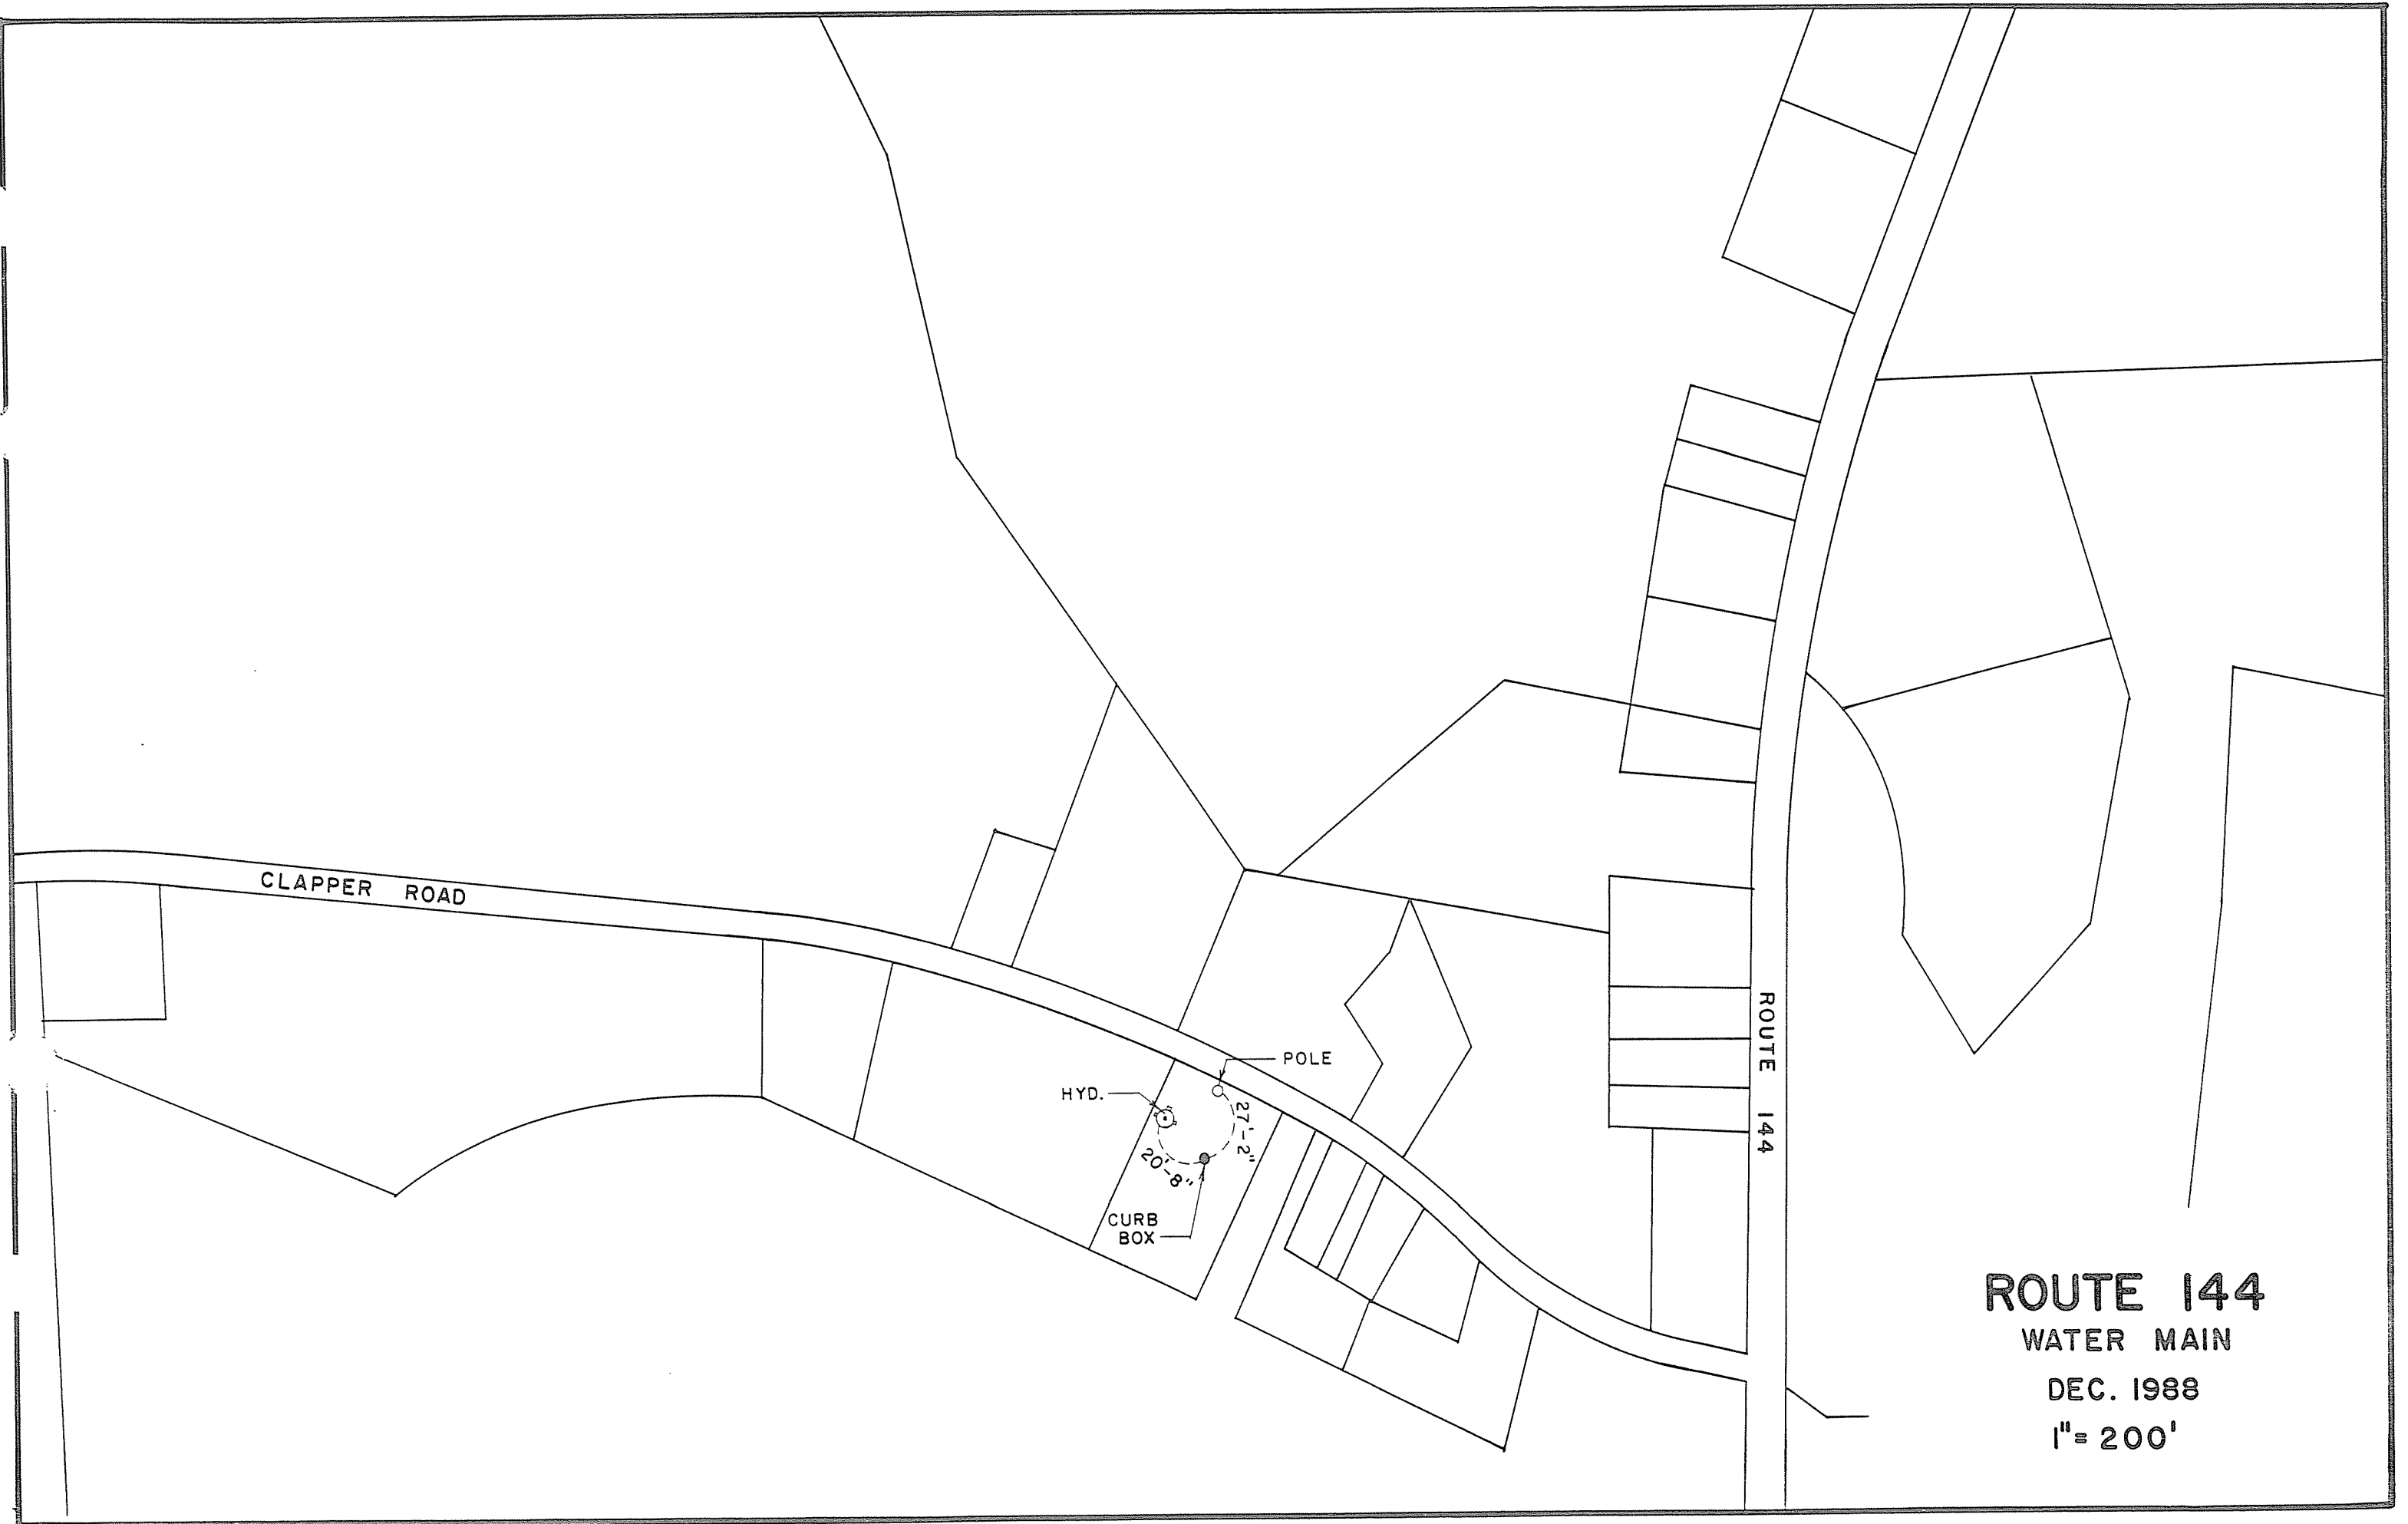

ROUTE 144
WATER MAIN
DEC. 1988
1" = 200'