


ROUTE 144
WATER DISTRICT NO. 1
TOWN OF BETHLEHEM ENG. DEPT.
RECORD OF INSTALLATION
SCALE 1" = 200'

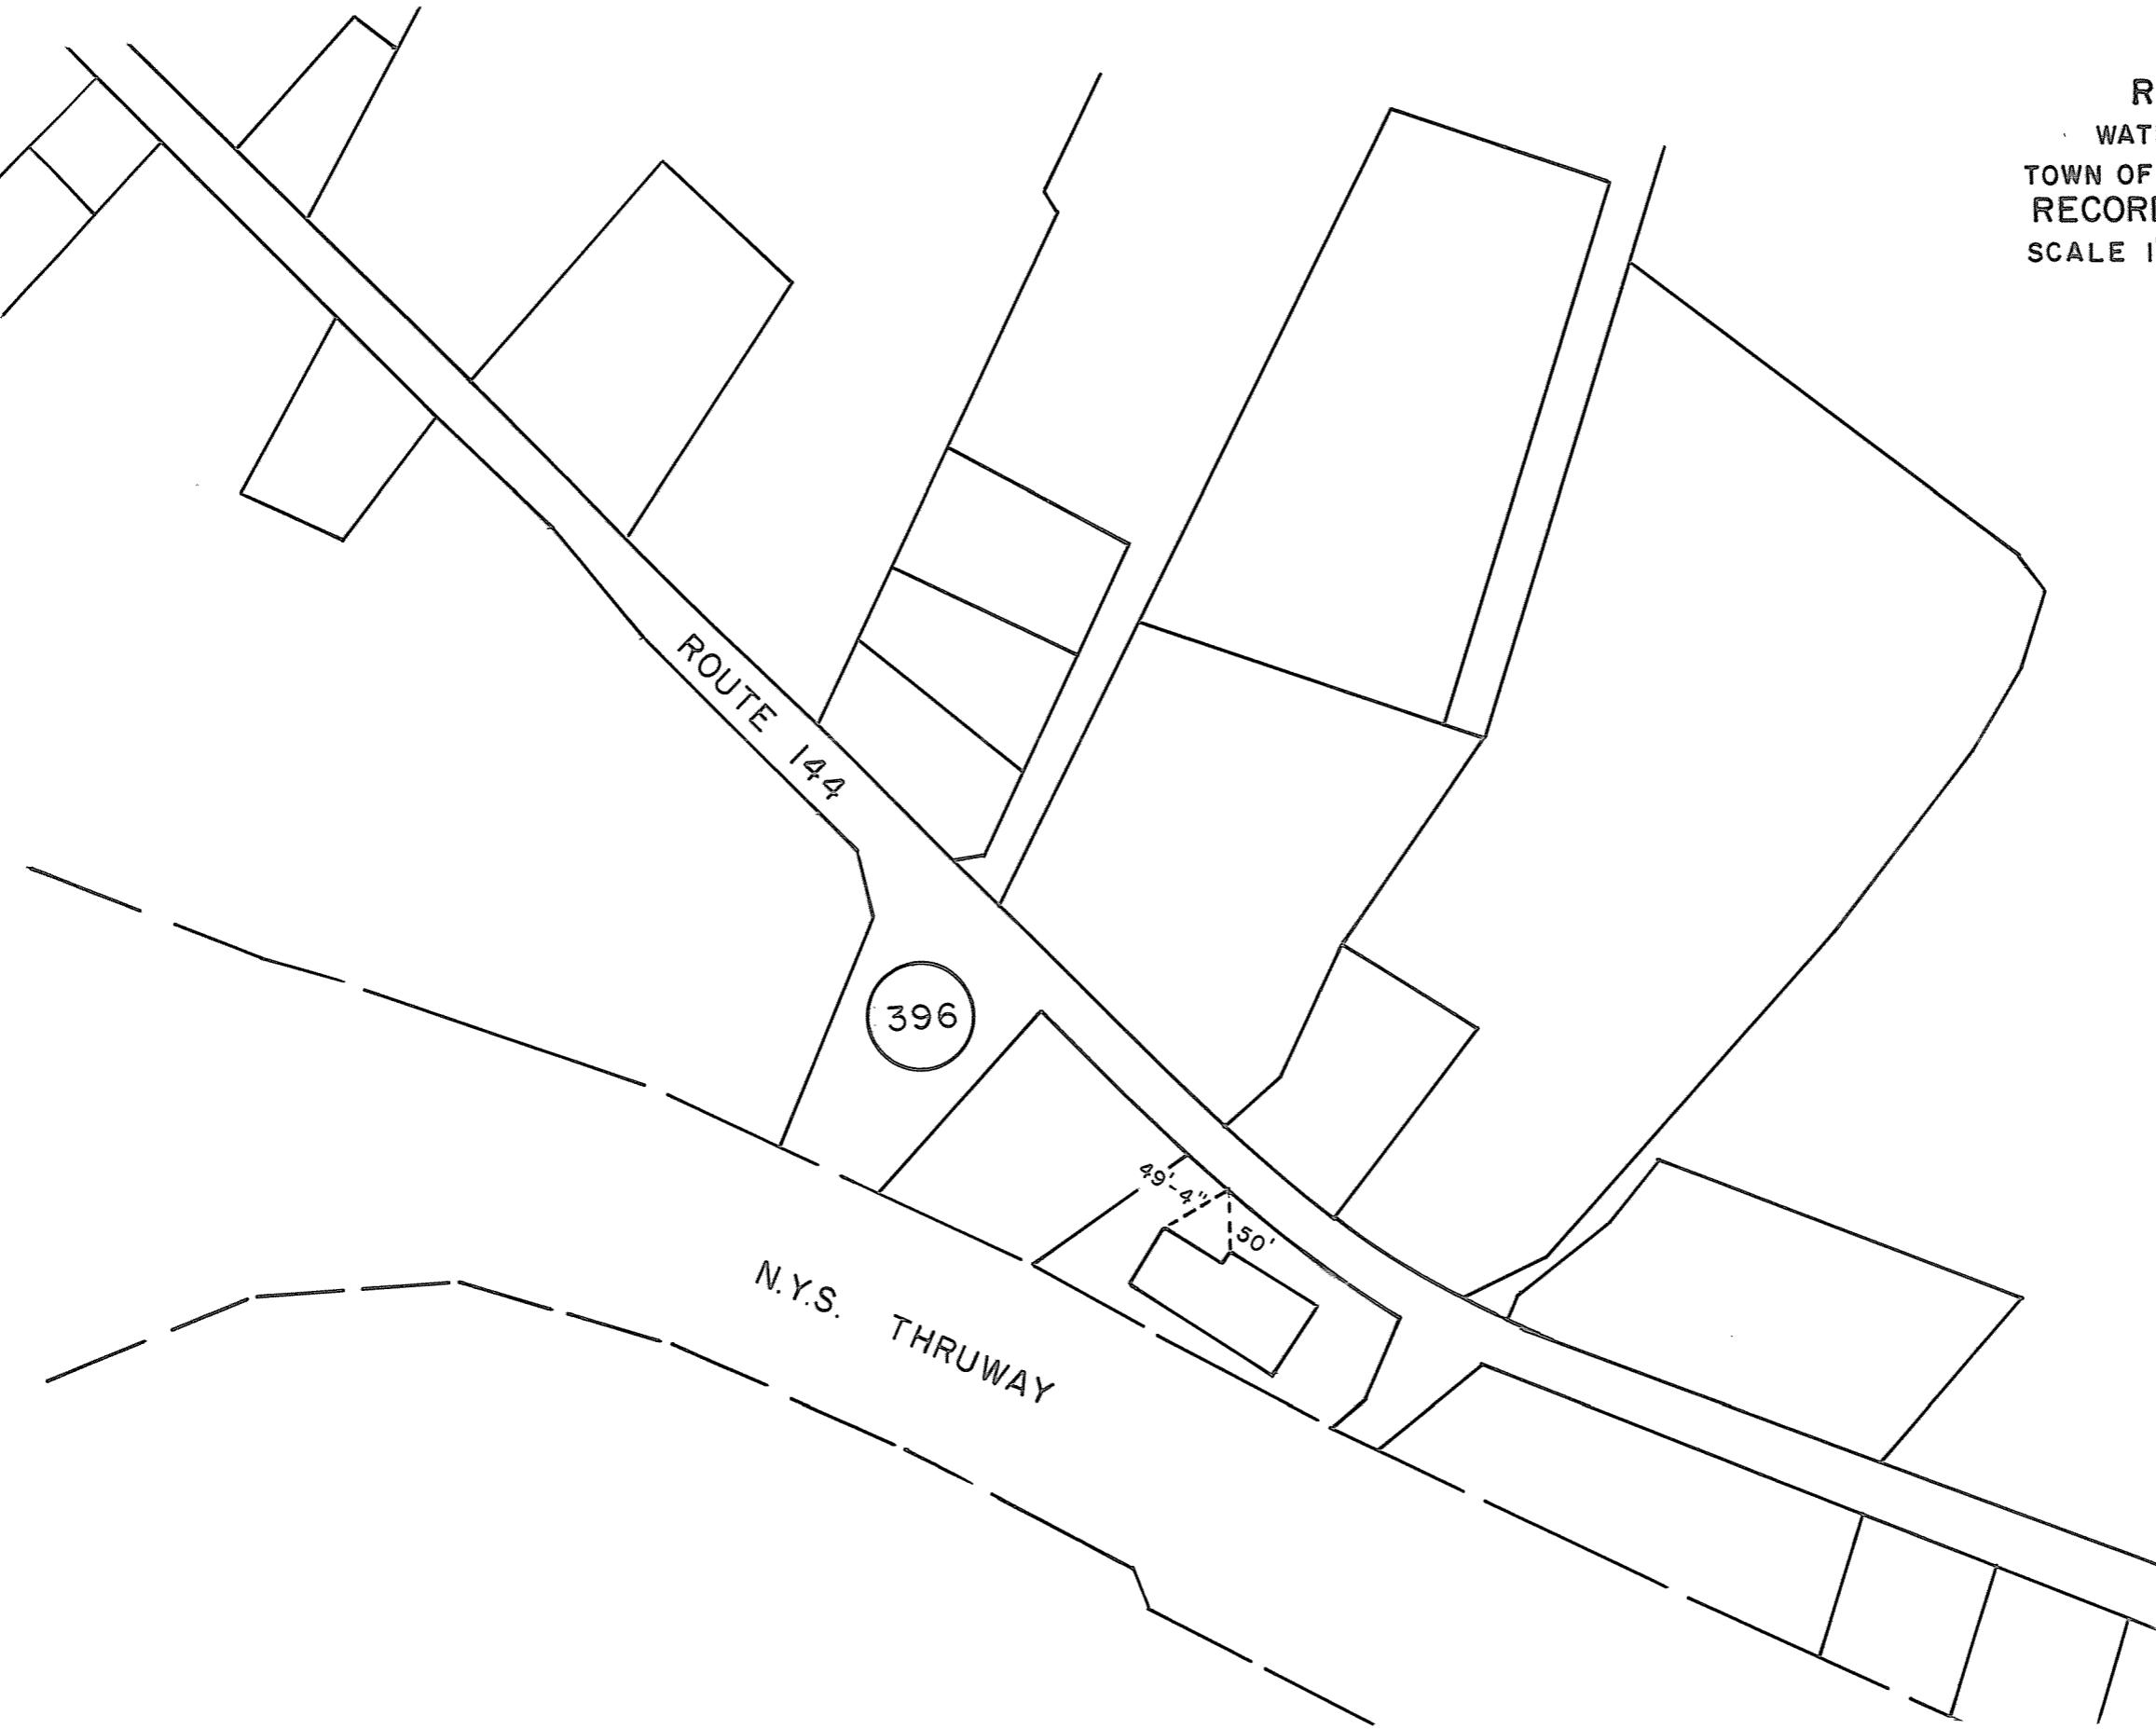

D.M.S.