


ROUTE 9W



MAGEE DRIVE

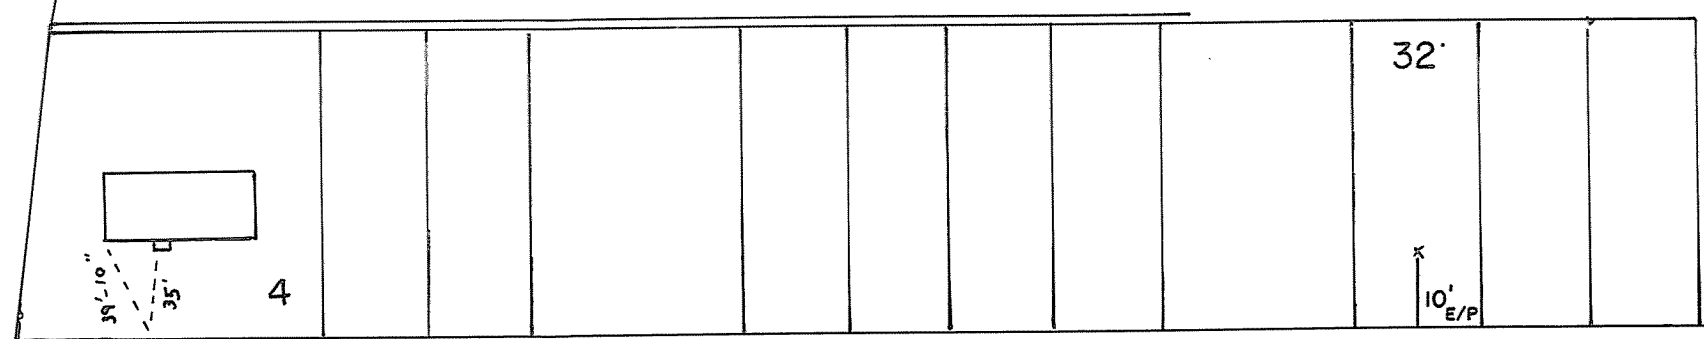