



SANDHURST

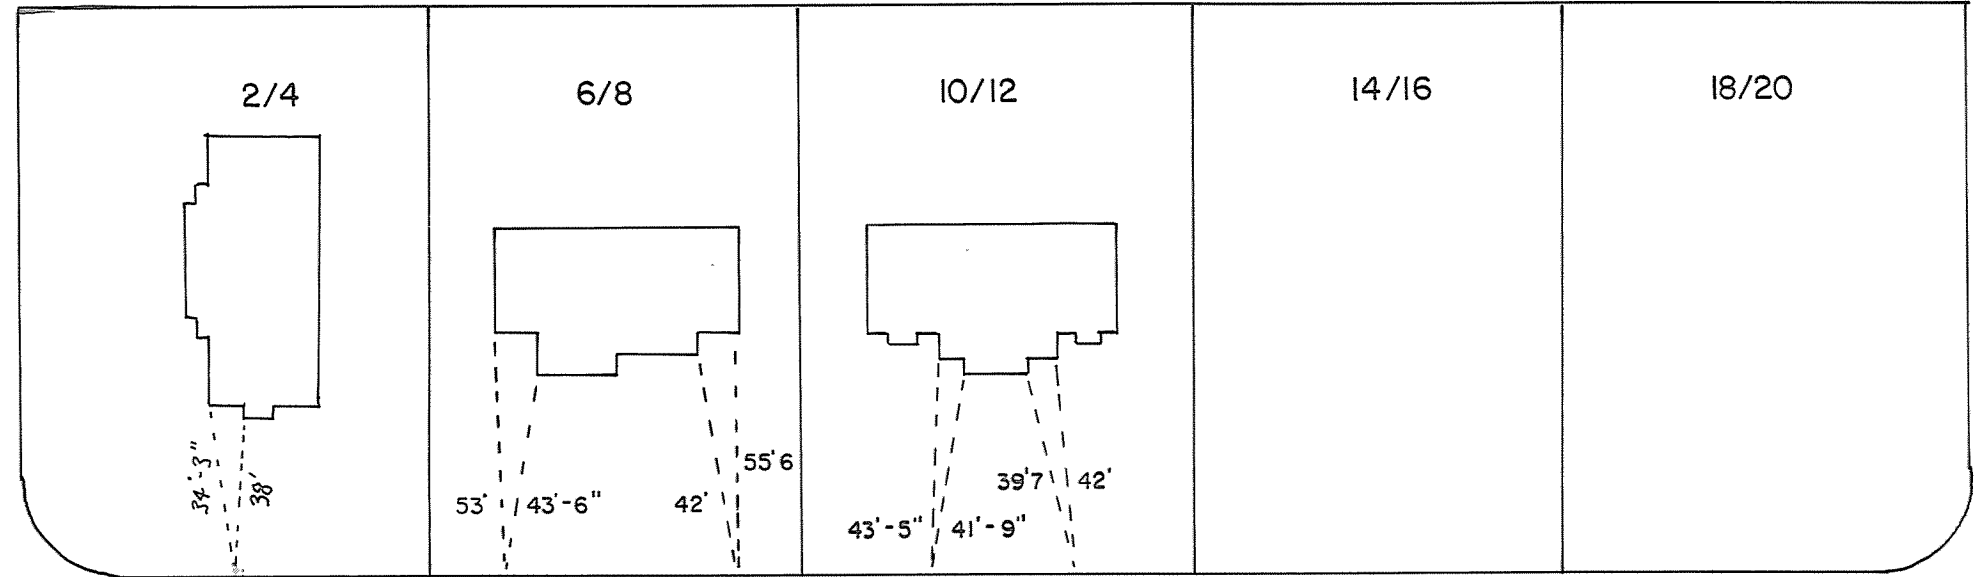

RUGBY ROAD

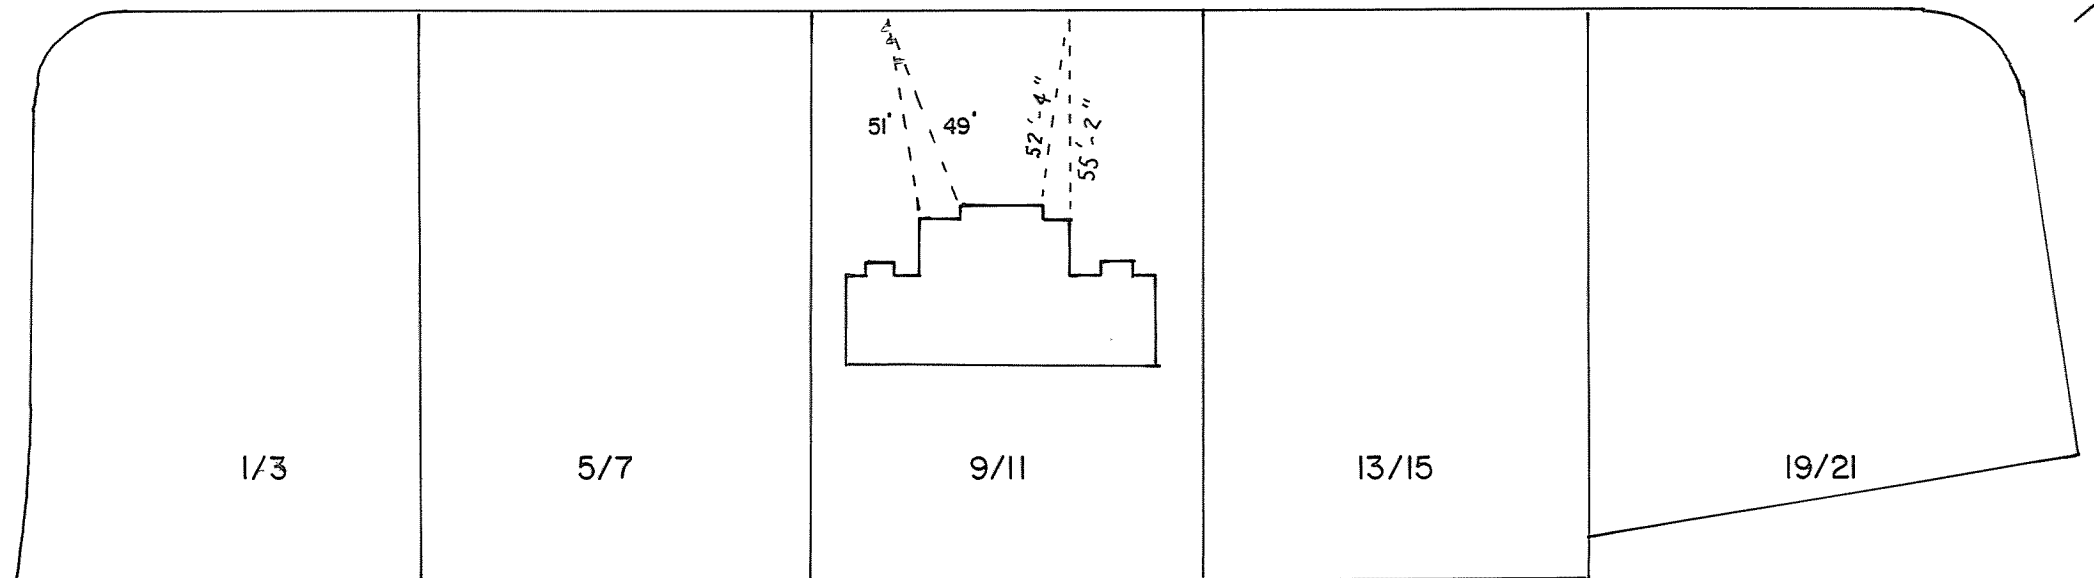

RUGBY ROAD

MEADOWBROOK