


RUSFIELD DRIVE
 WATER DISTRICT NO. 1
 TOWN OF BETHLEHEM
 RECORD OF INSTALLATION
 TOWN OF BETHLEHEM ENGINEERING
 DEPARTMENT
 SCALE: 1"=50' JULY, 1987
 DWN. BY: S.P.

DRIVE

EX MH 27

COMMONWEALTH

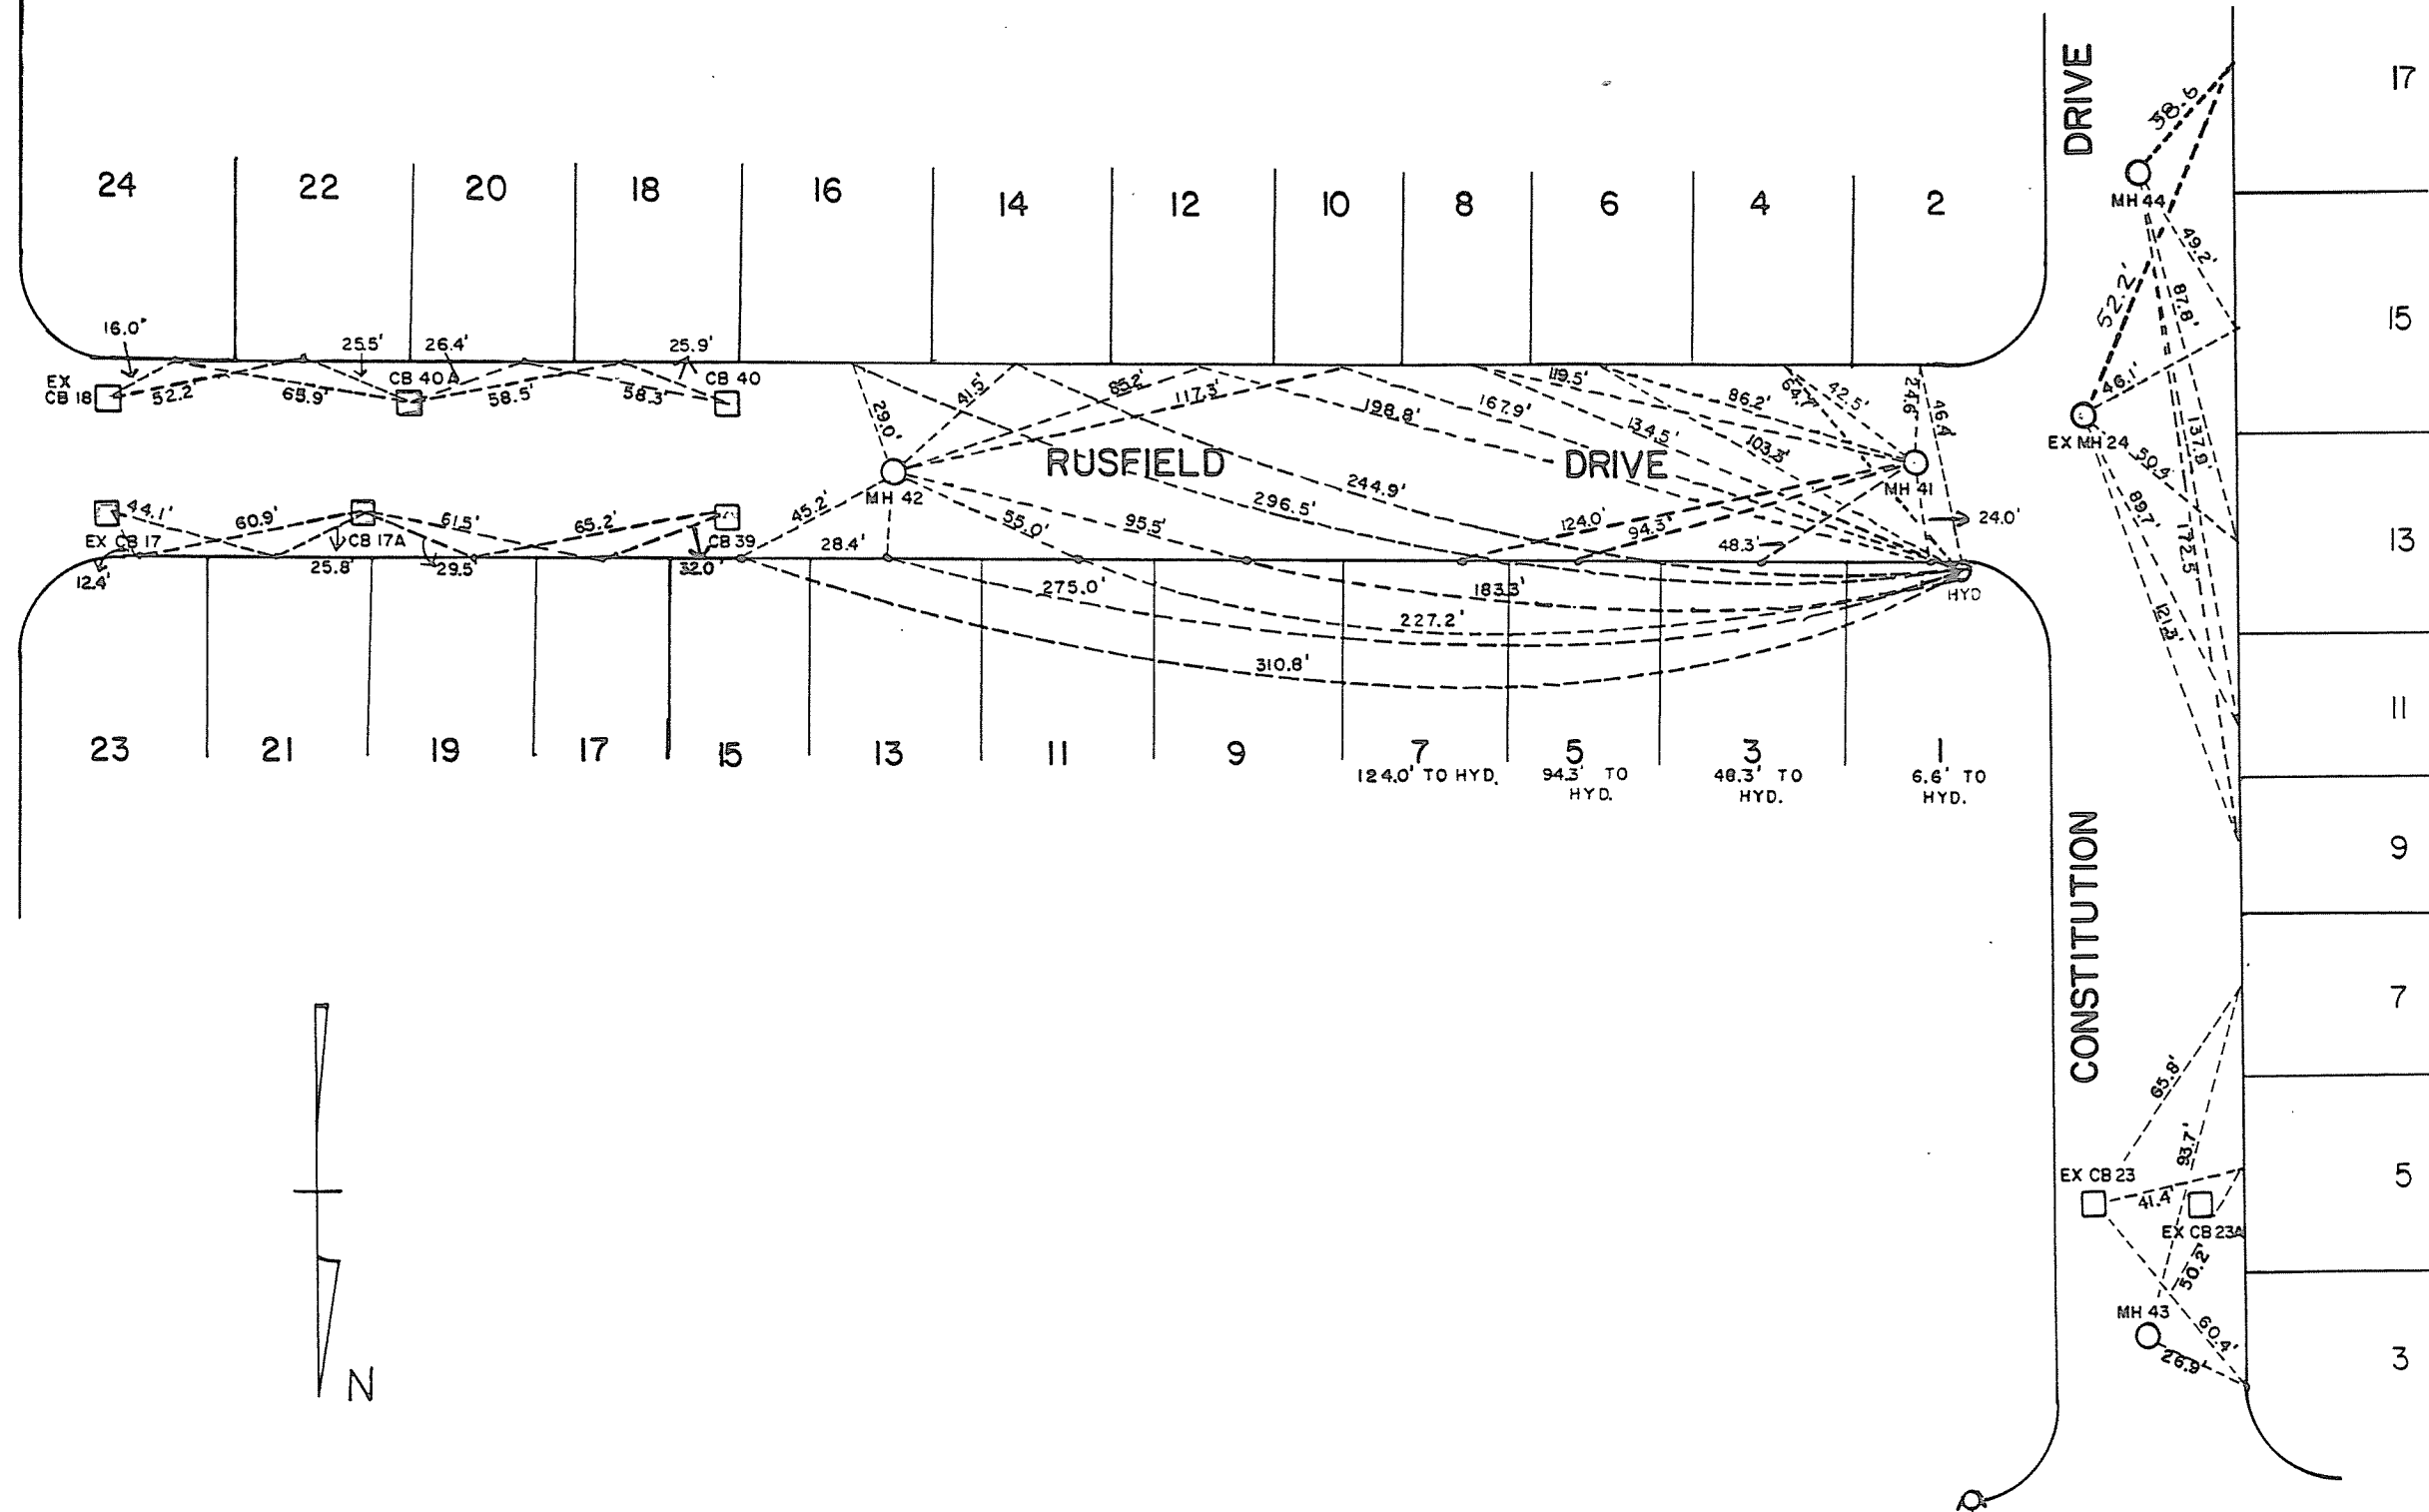

17

15

13

11

9

7

5

3