


1- 87

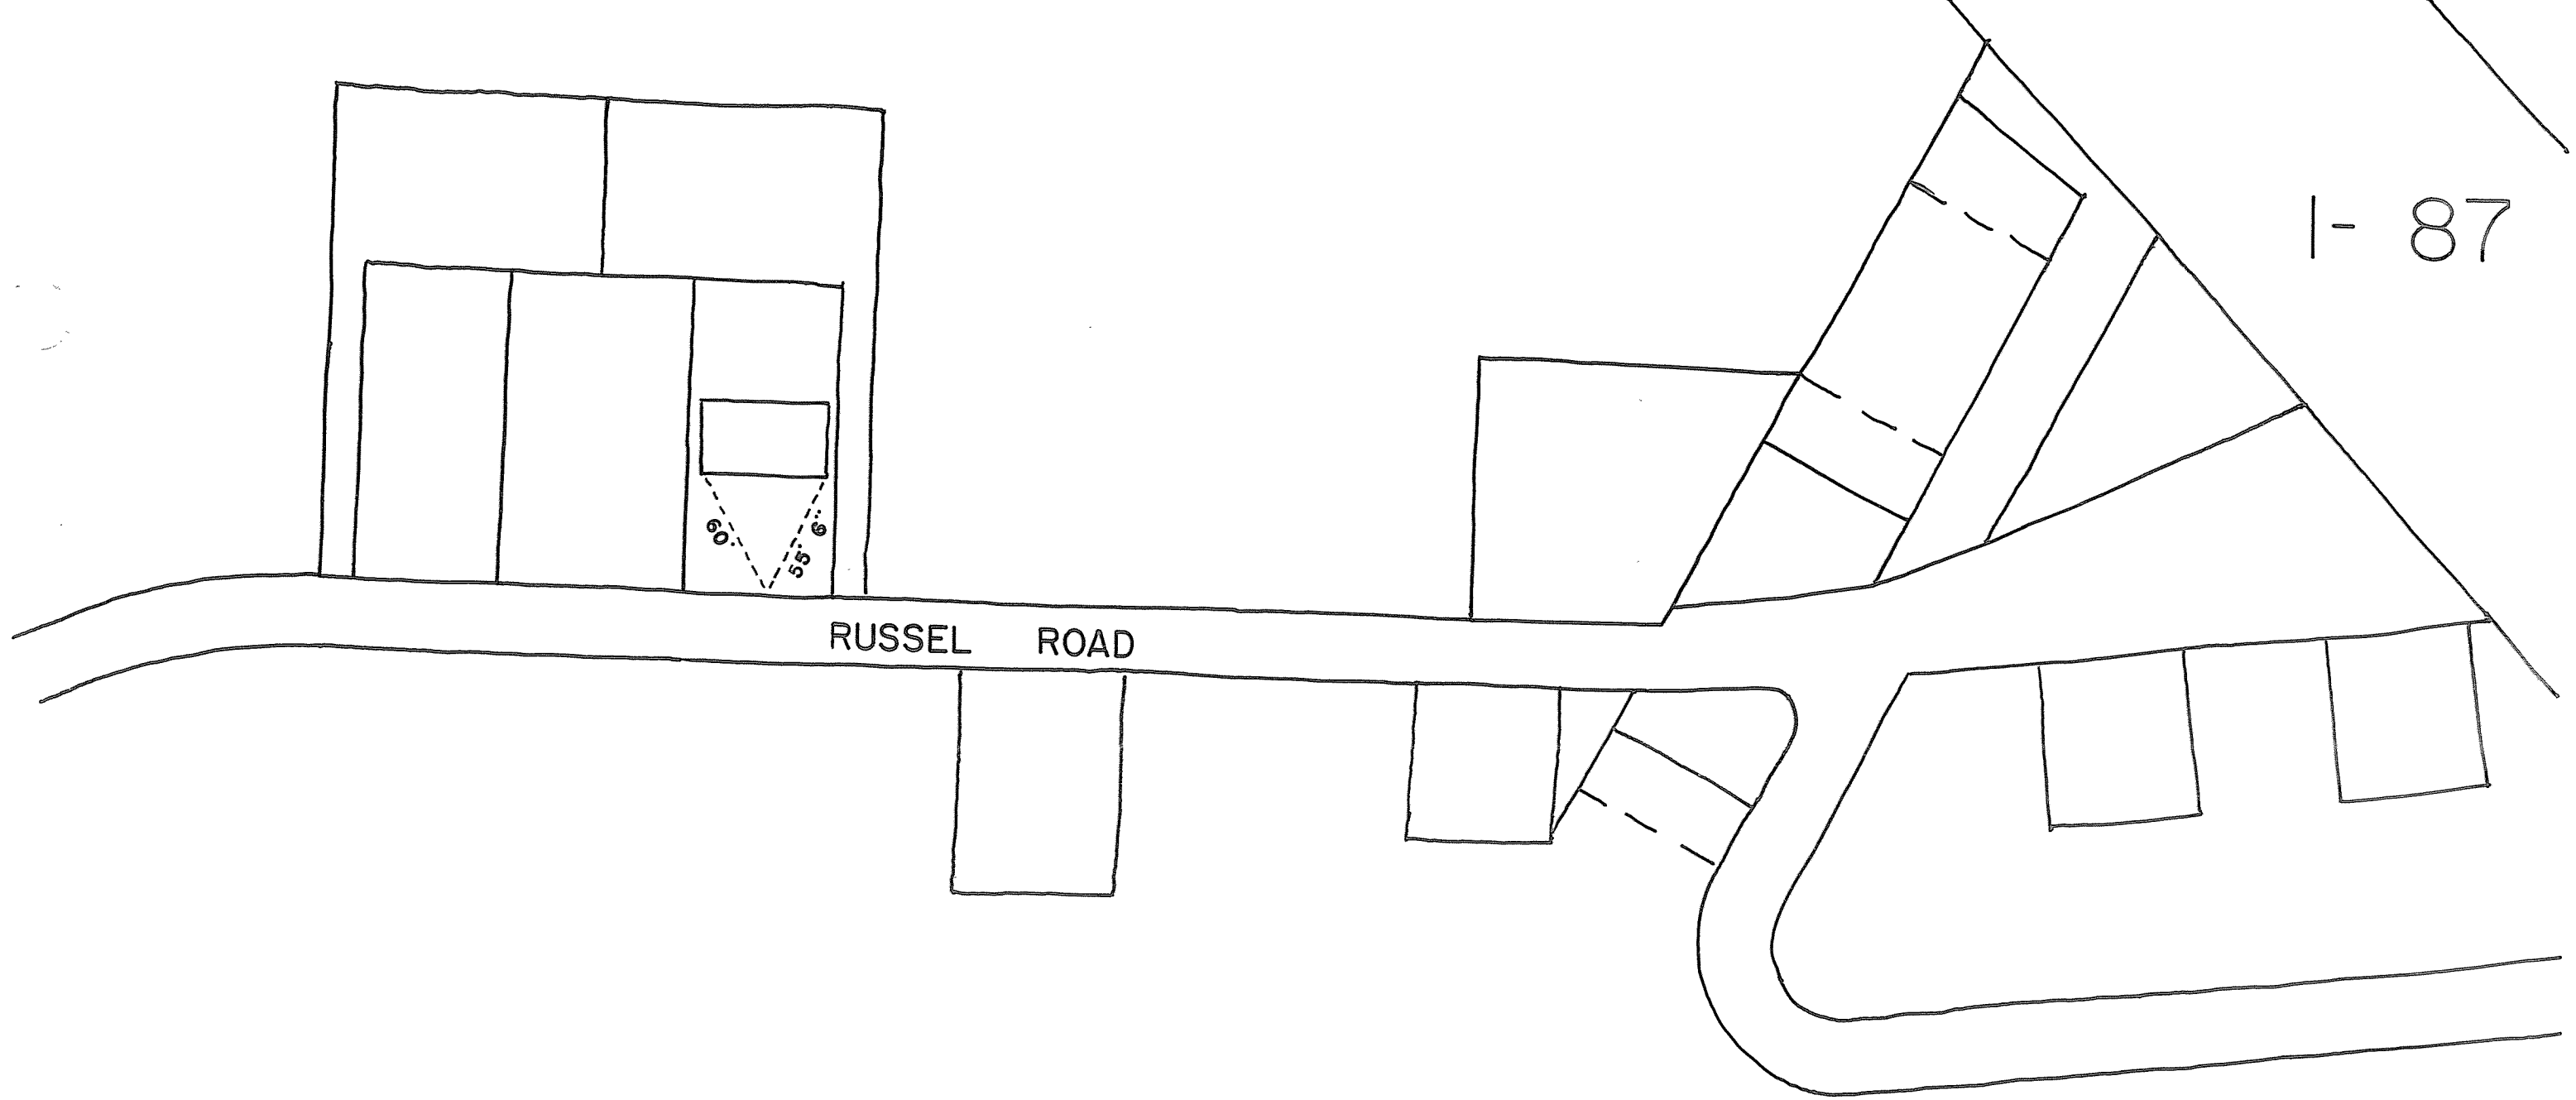

RUSSELL ROAD