


RUSSELL ROAD  
WATER DISTRICT NO. 1  
TOWN OF BETHLEHEM  
RECORD OF INSTALLATION  
TOWN OF BETHLEHEM ENGINEERING  
DEPARTMENT  
SCALE: 1"=50' JANUARY, 1983  
DWN. BY: PDH

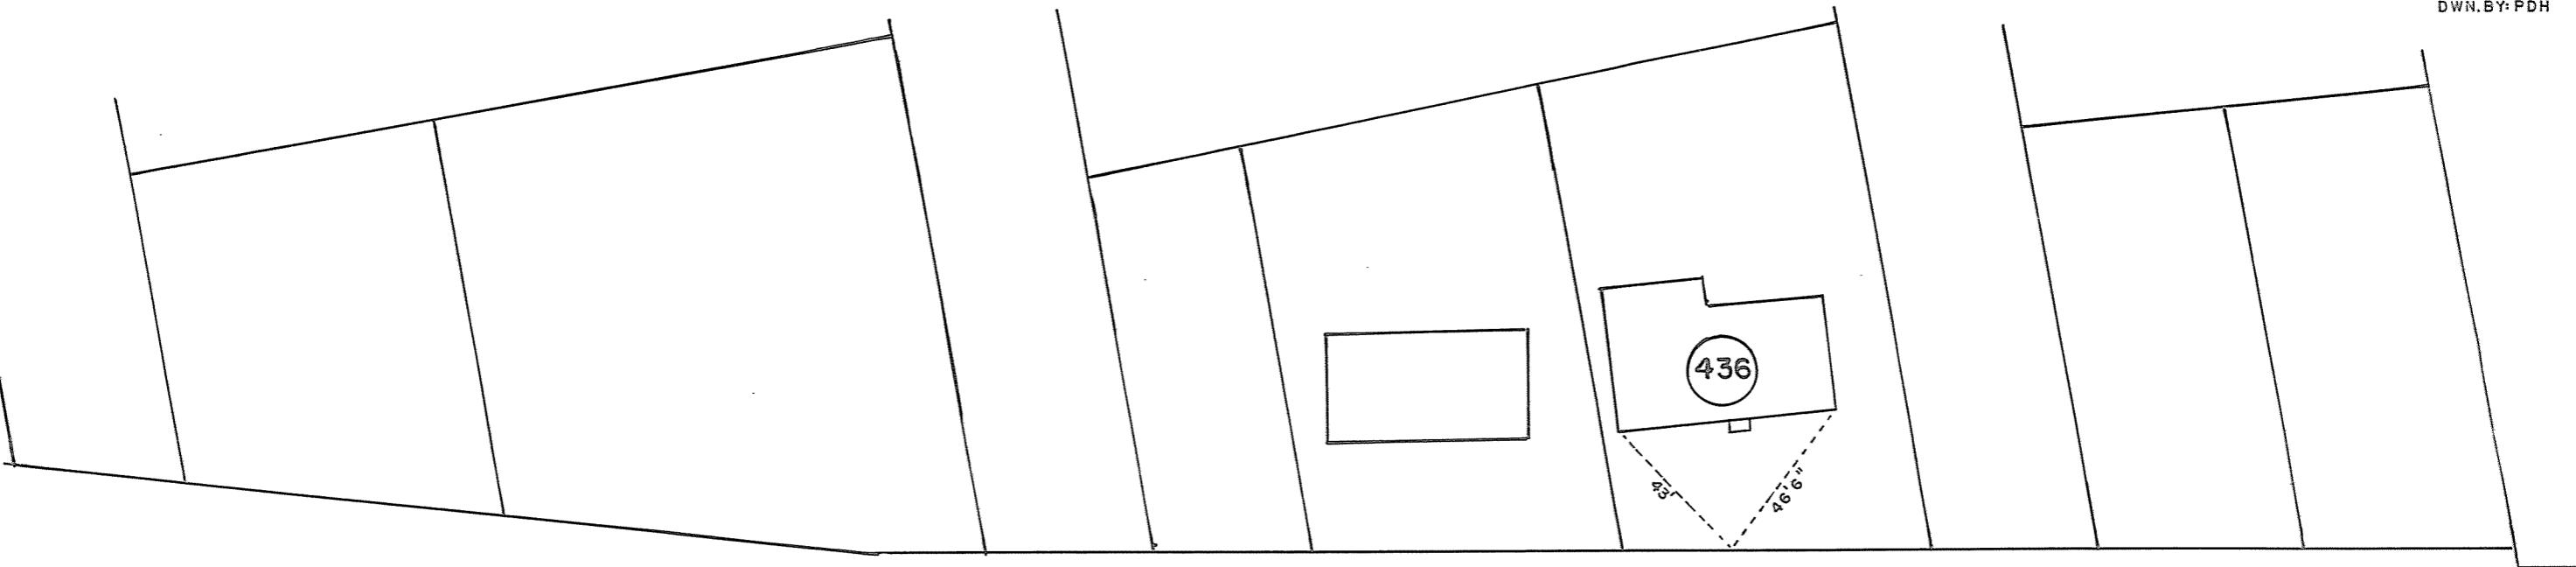

RUSSELL

ROAD

THE  
CONCOURSE

