



RUXTON ROAD
"BRIARHILL"

WATER DISTRICT NO. 1
TOWN OF BETHLEHEM

RECORD OF INSTALLATION
TOWN OF BETHLEHEM ENGINEERING

DEPARTMENT
SCALE 1"=50' DECEMBER, 1981
DWN BY: PDH

9

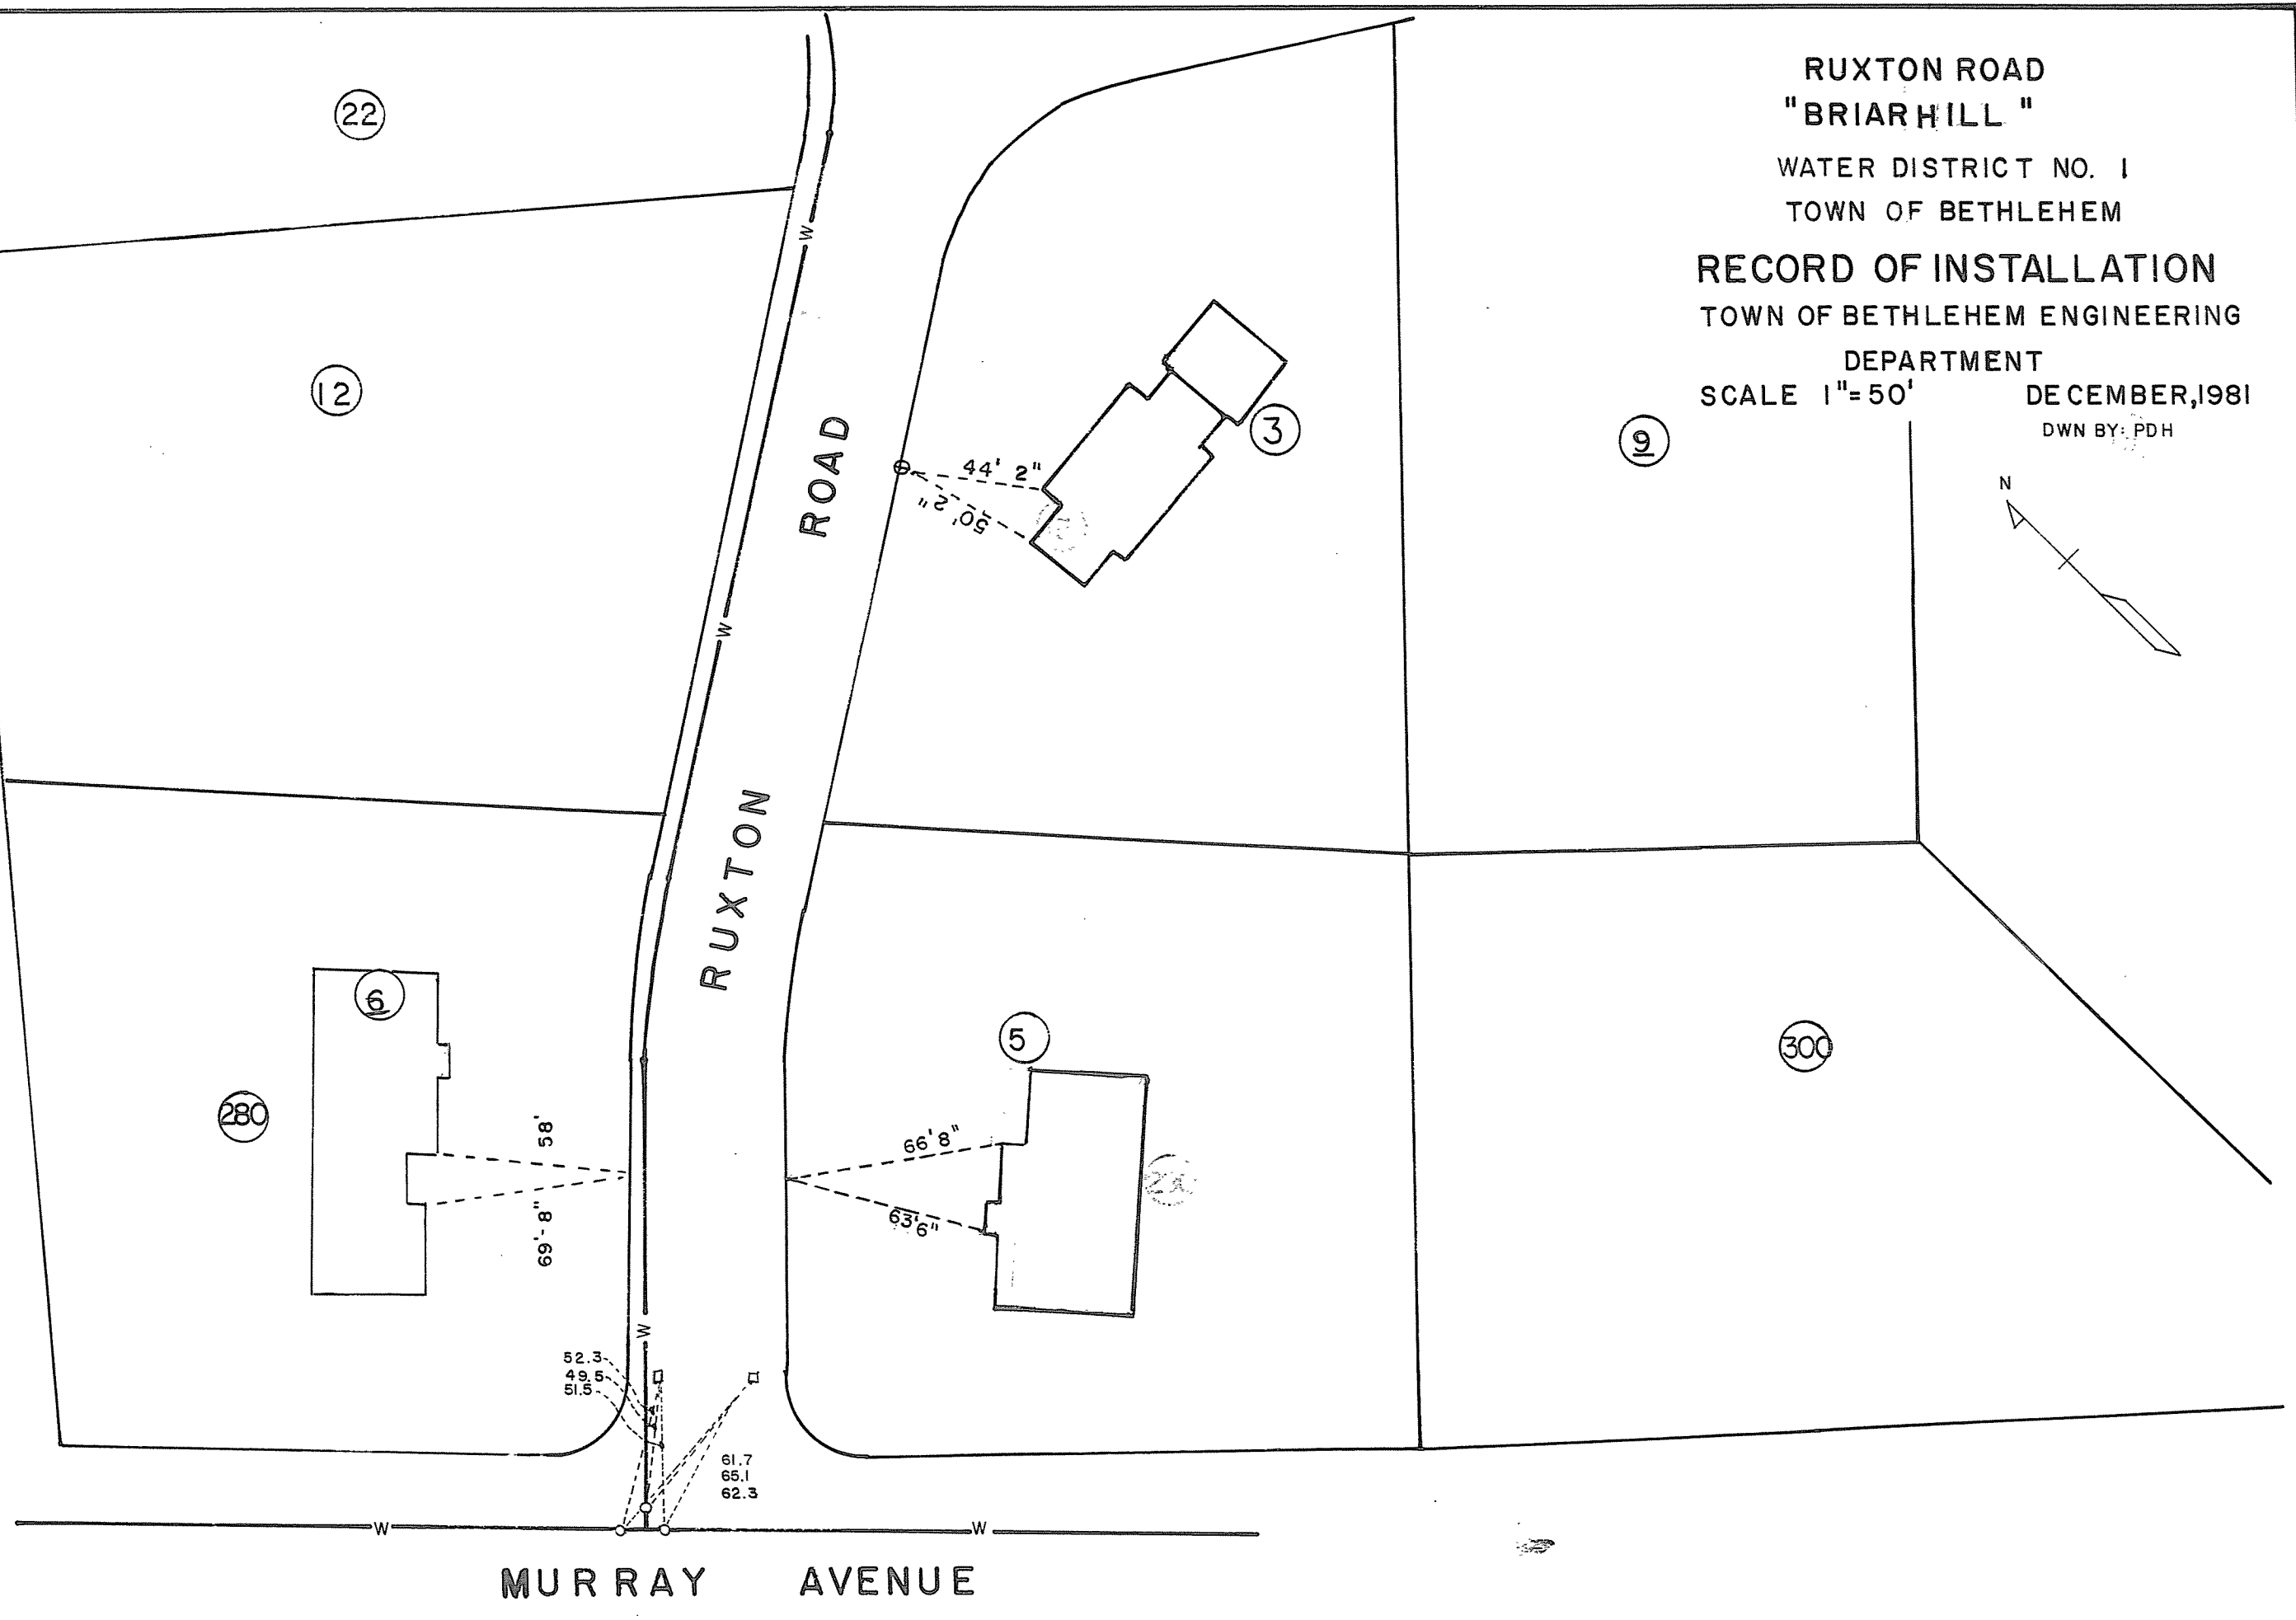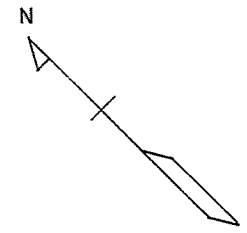

MURRAY AVENUE