


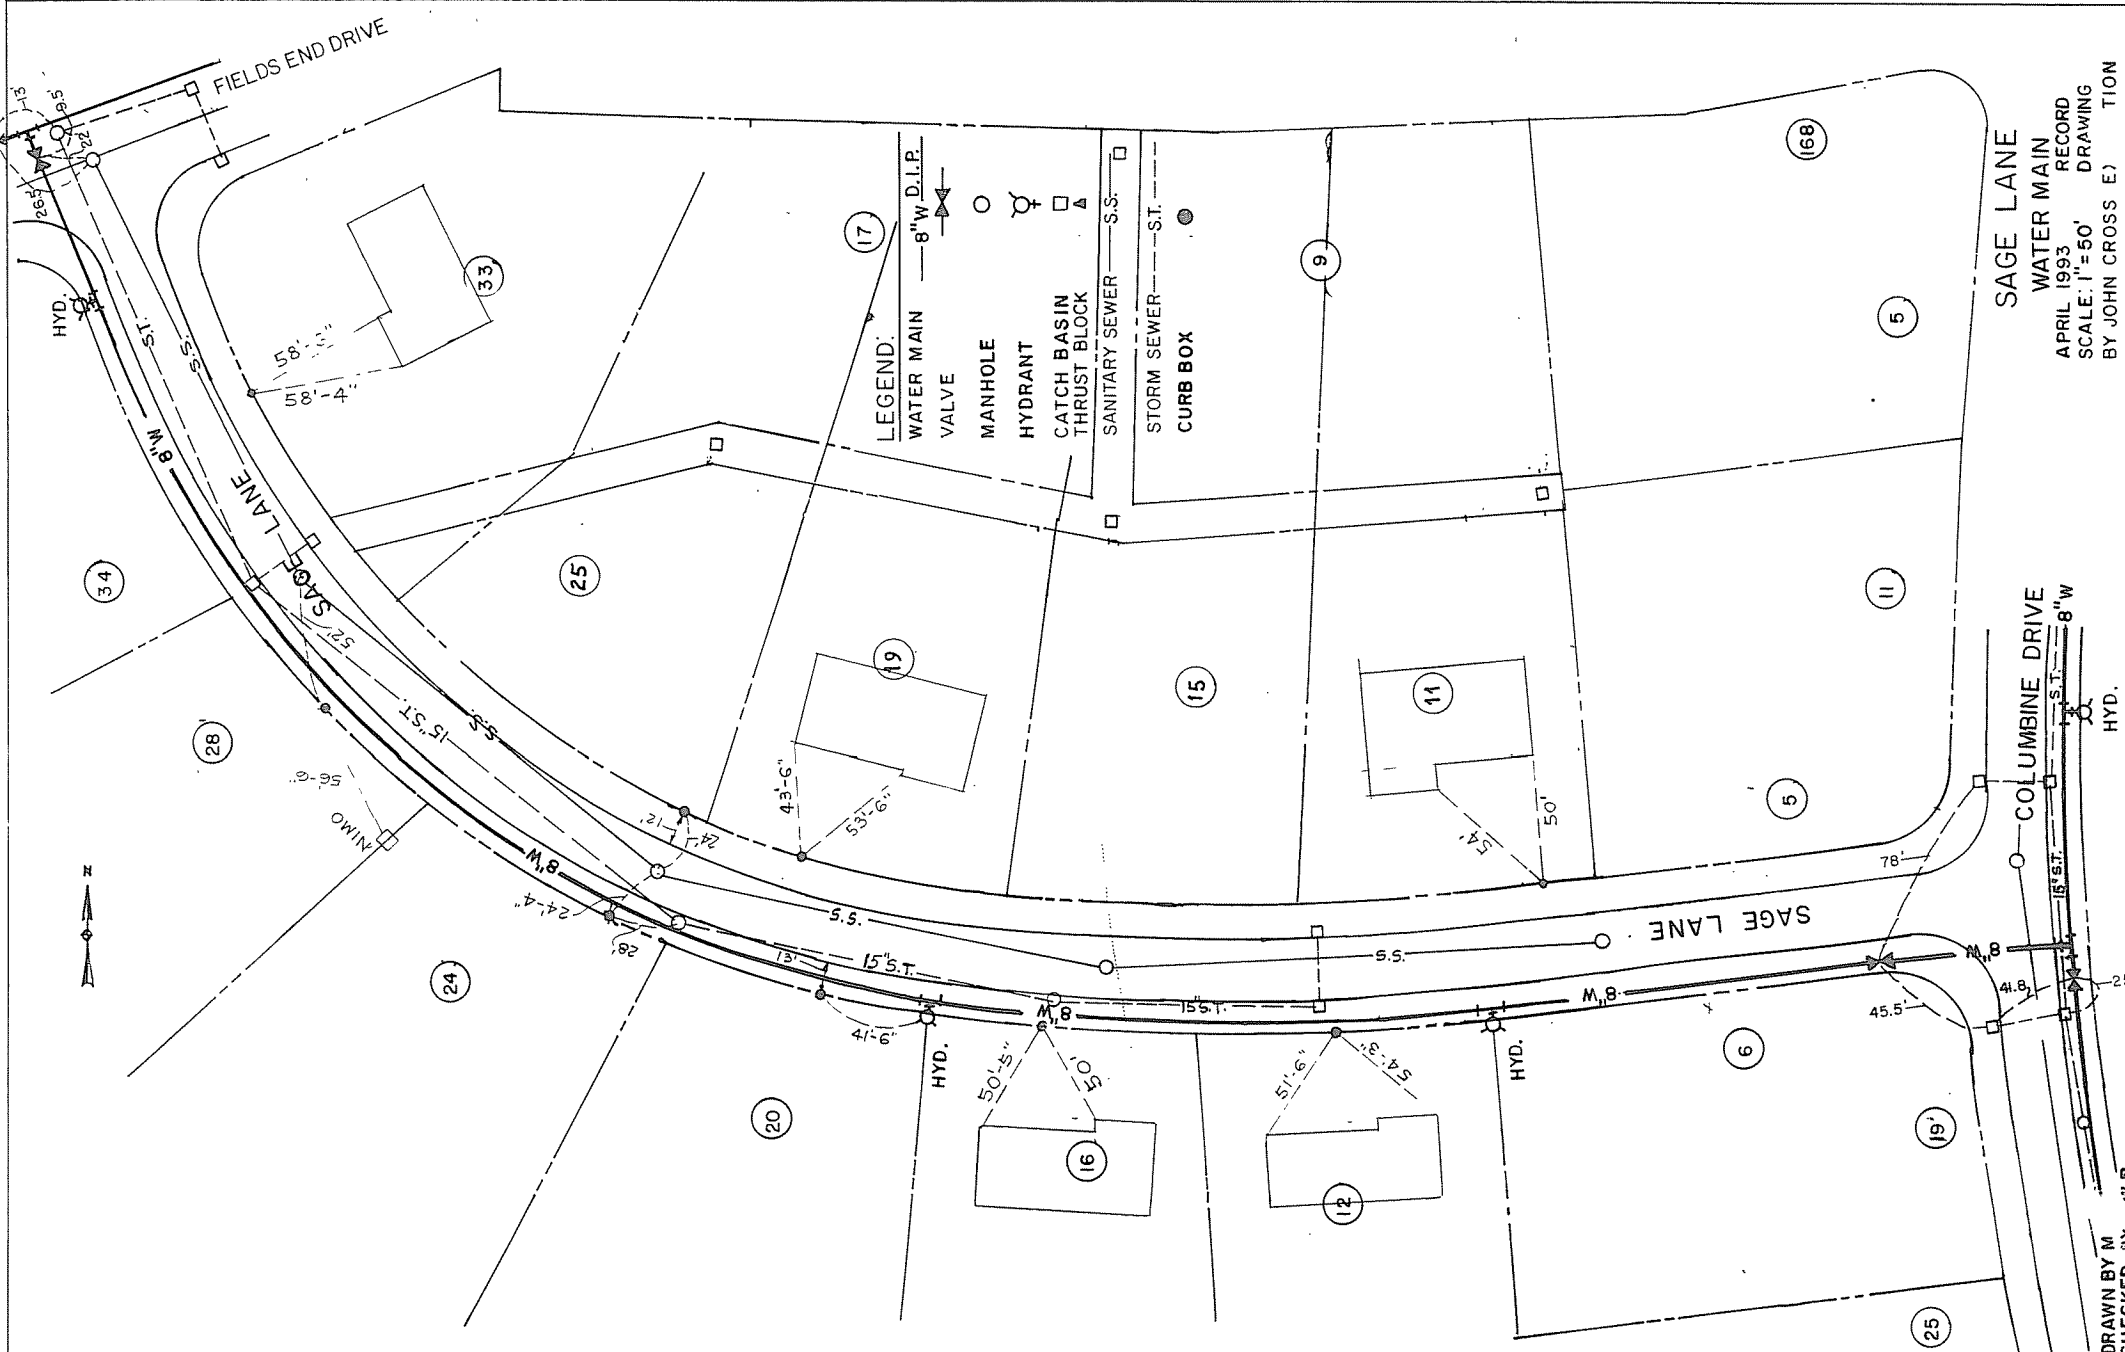

SAGE LANE

WATER MAIN

APRIL 1993

SCALE: 1"=50'

BY JOHN CROSS E.T.

DRAWN BY M

CHECKED BY J.W.R.

COLUMBINE DRIVE

8" W

HYD.