


DELAWARE AVE

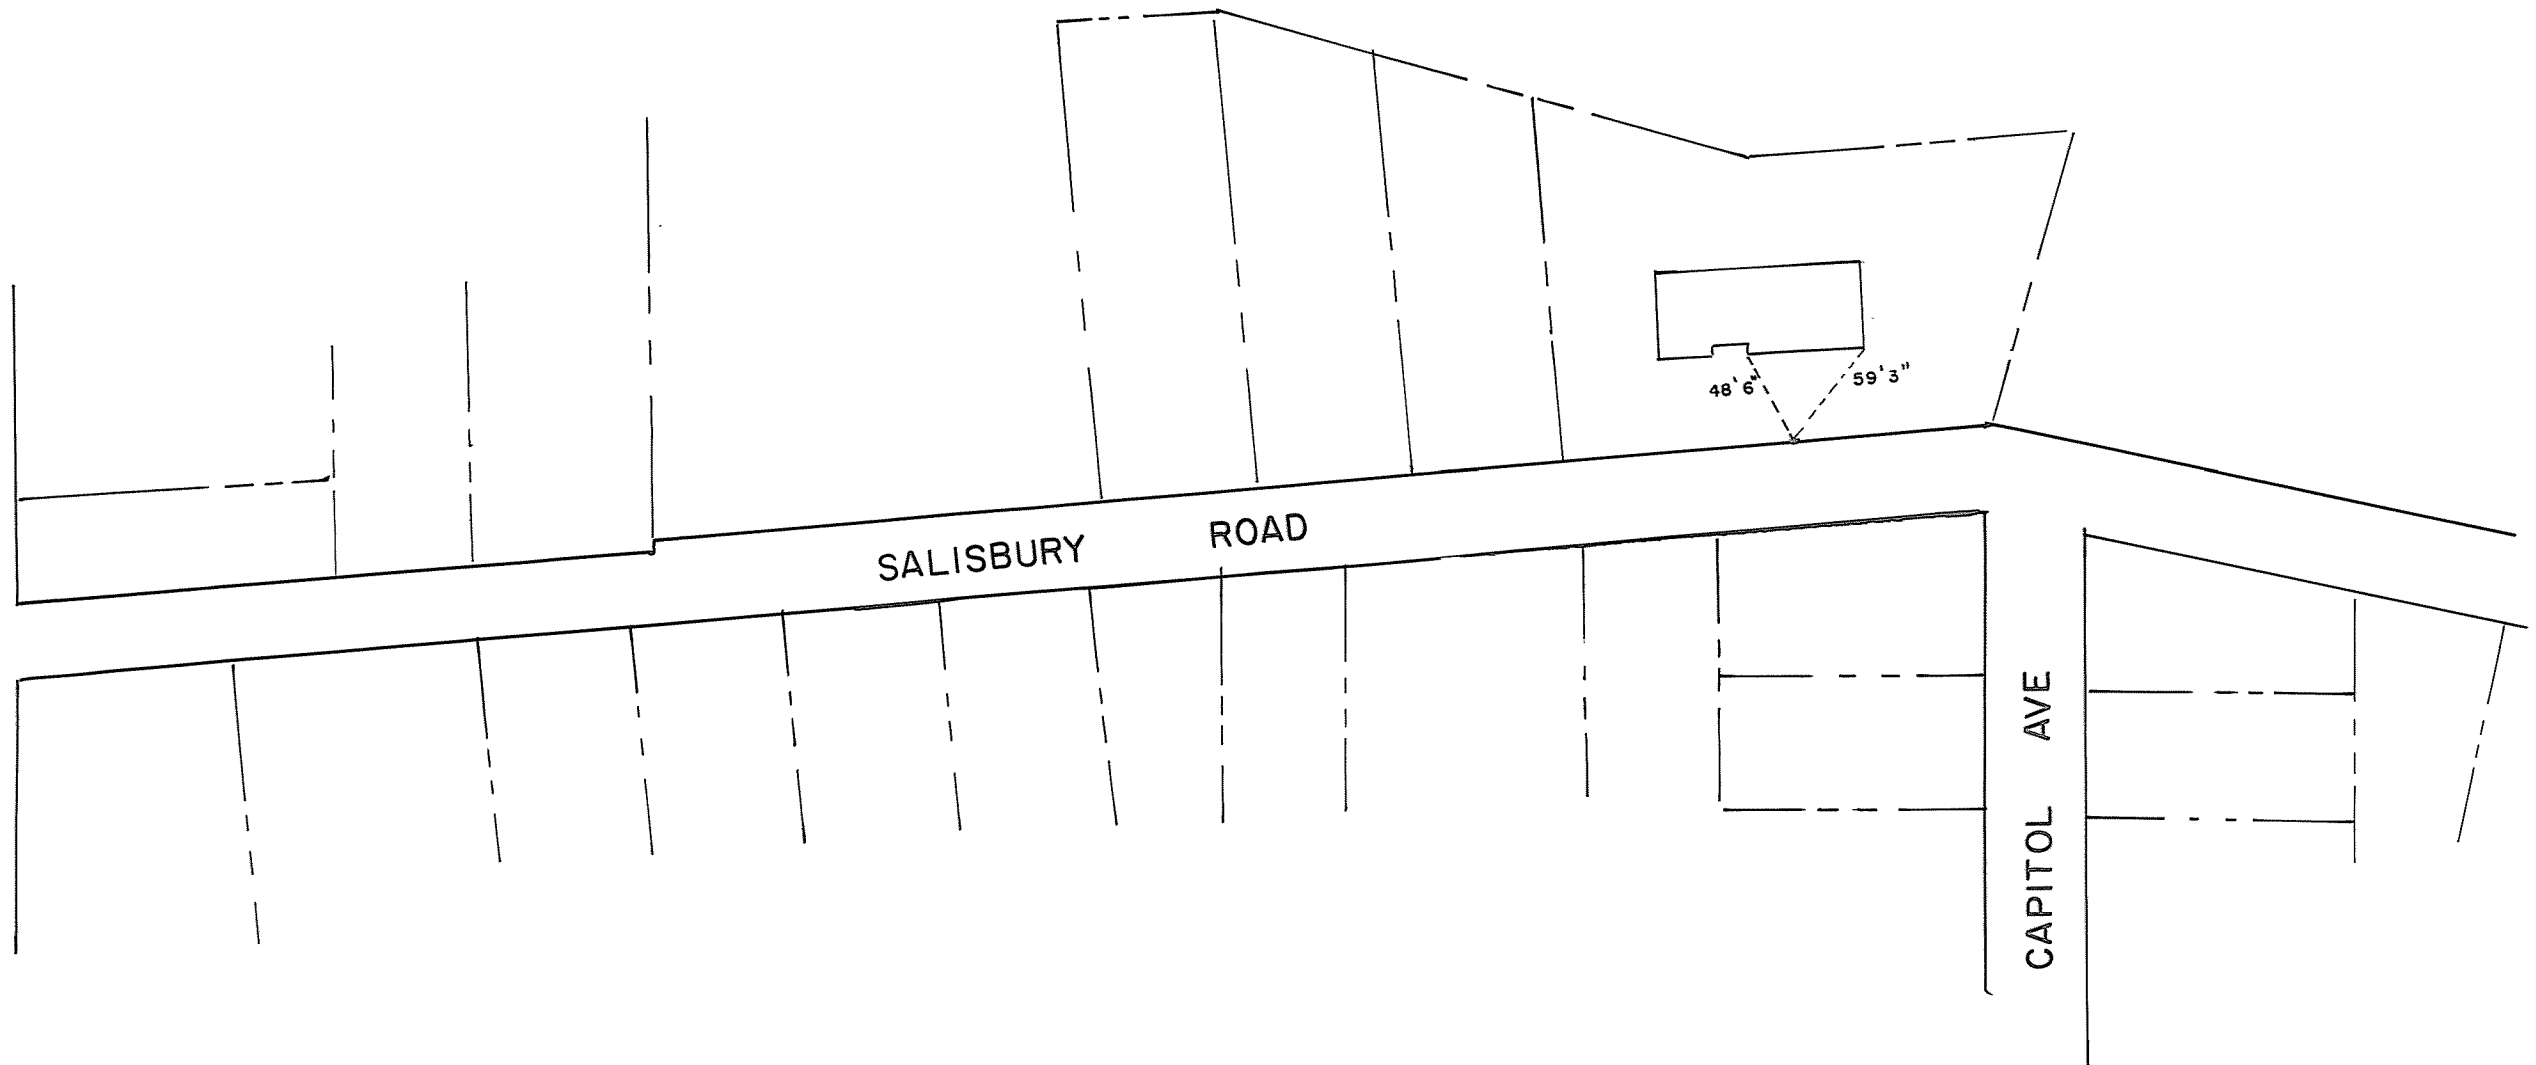

SALISBURY ROAD
WATER DISTRICT NO. 1
TOWN OF BETHLEHEM
RECORD OF INSTALLATION
SCALE 1" = 100 JULY 1988