


SALISBURY ROAD
WATER DISTRICT NO.1
TOWN OF BETHLEHEM
RECORD OF INSTALLATION
TOWN OF BETHLEHEM ENGINEERING
DEPARTMENT
SCALE: 1"= 50' NOVEMBER, 1982
DWN. BY: PDH

→ N

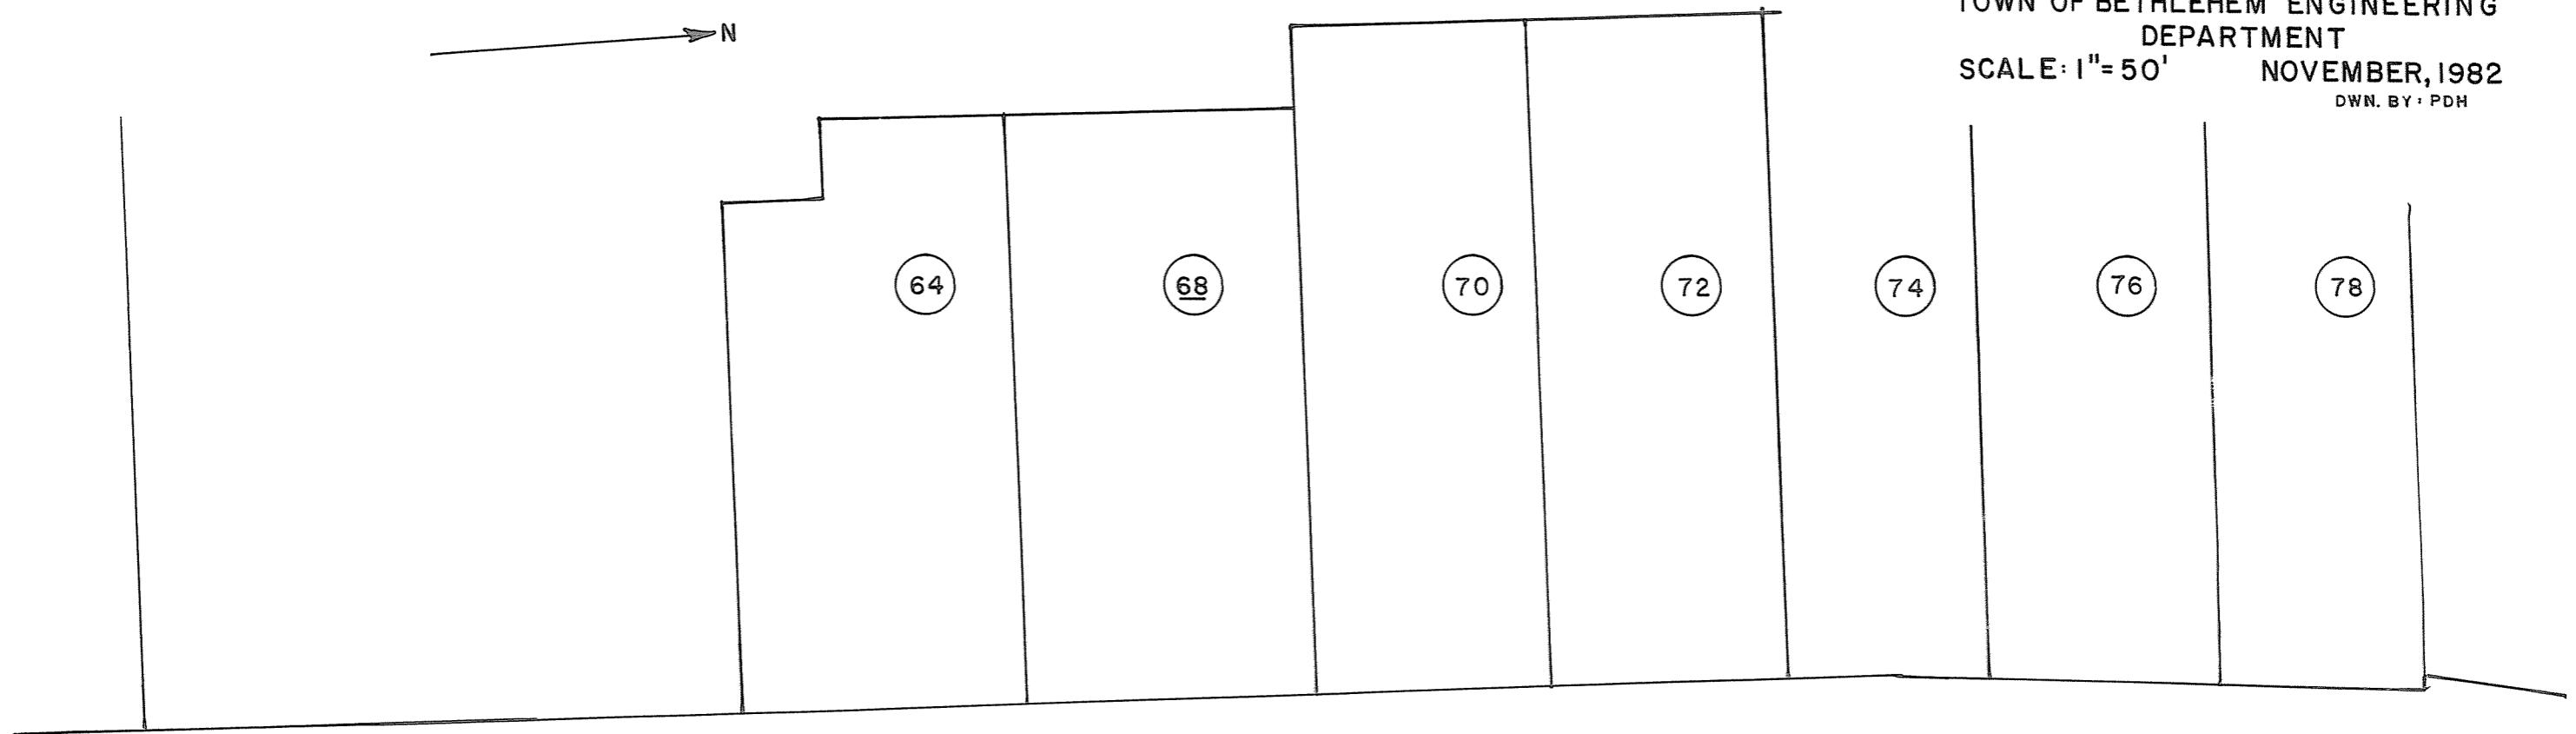

SALISBURY

ROAD

