


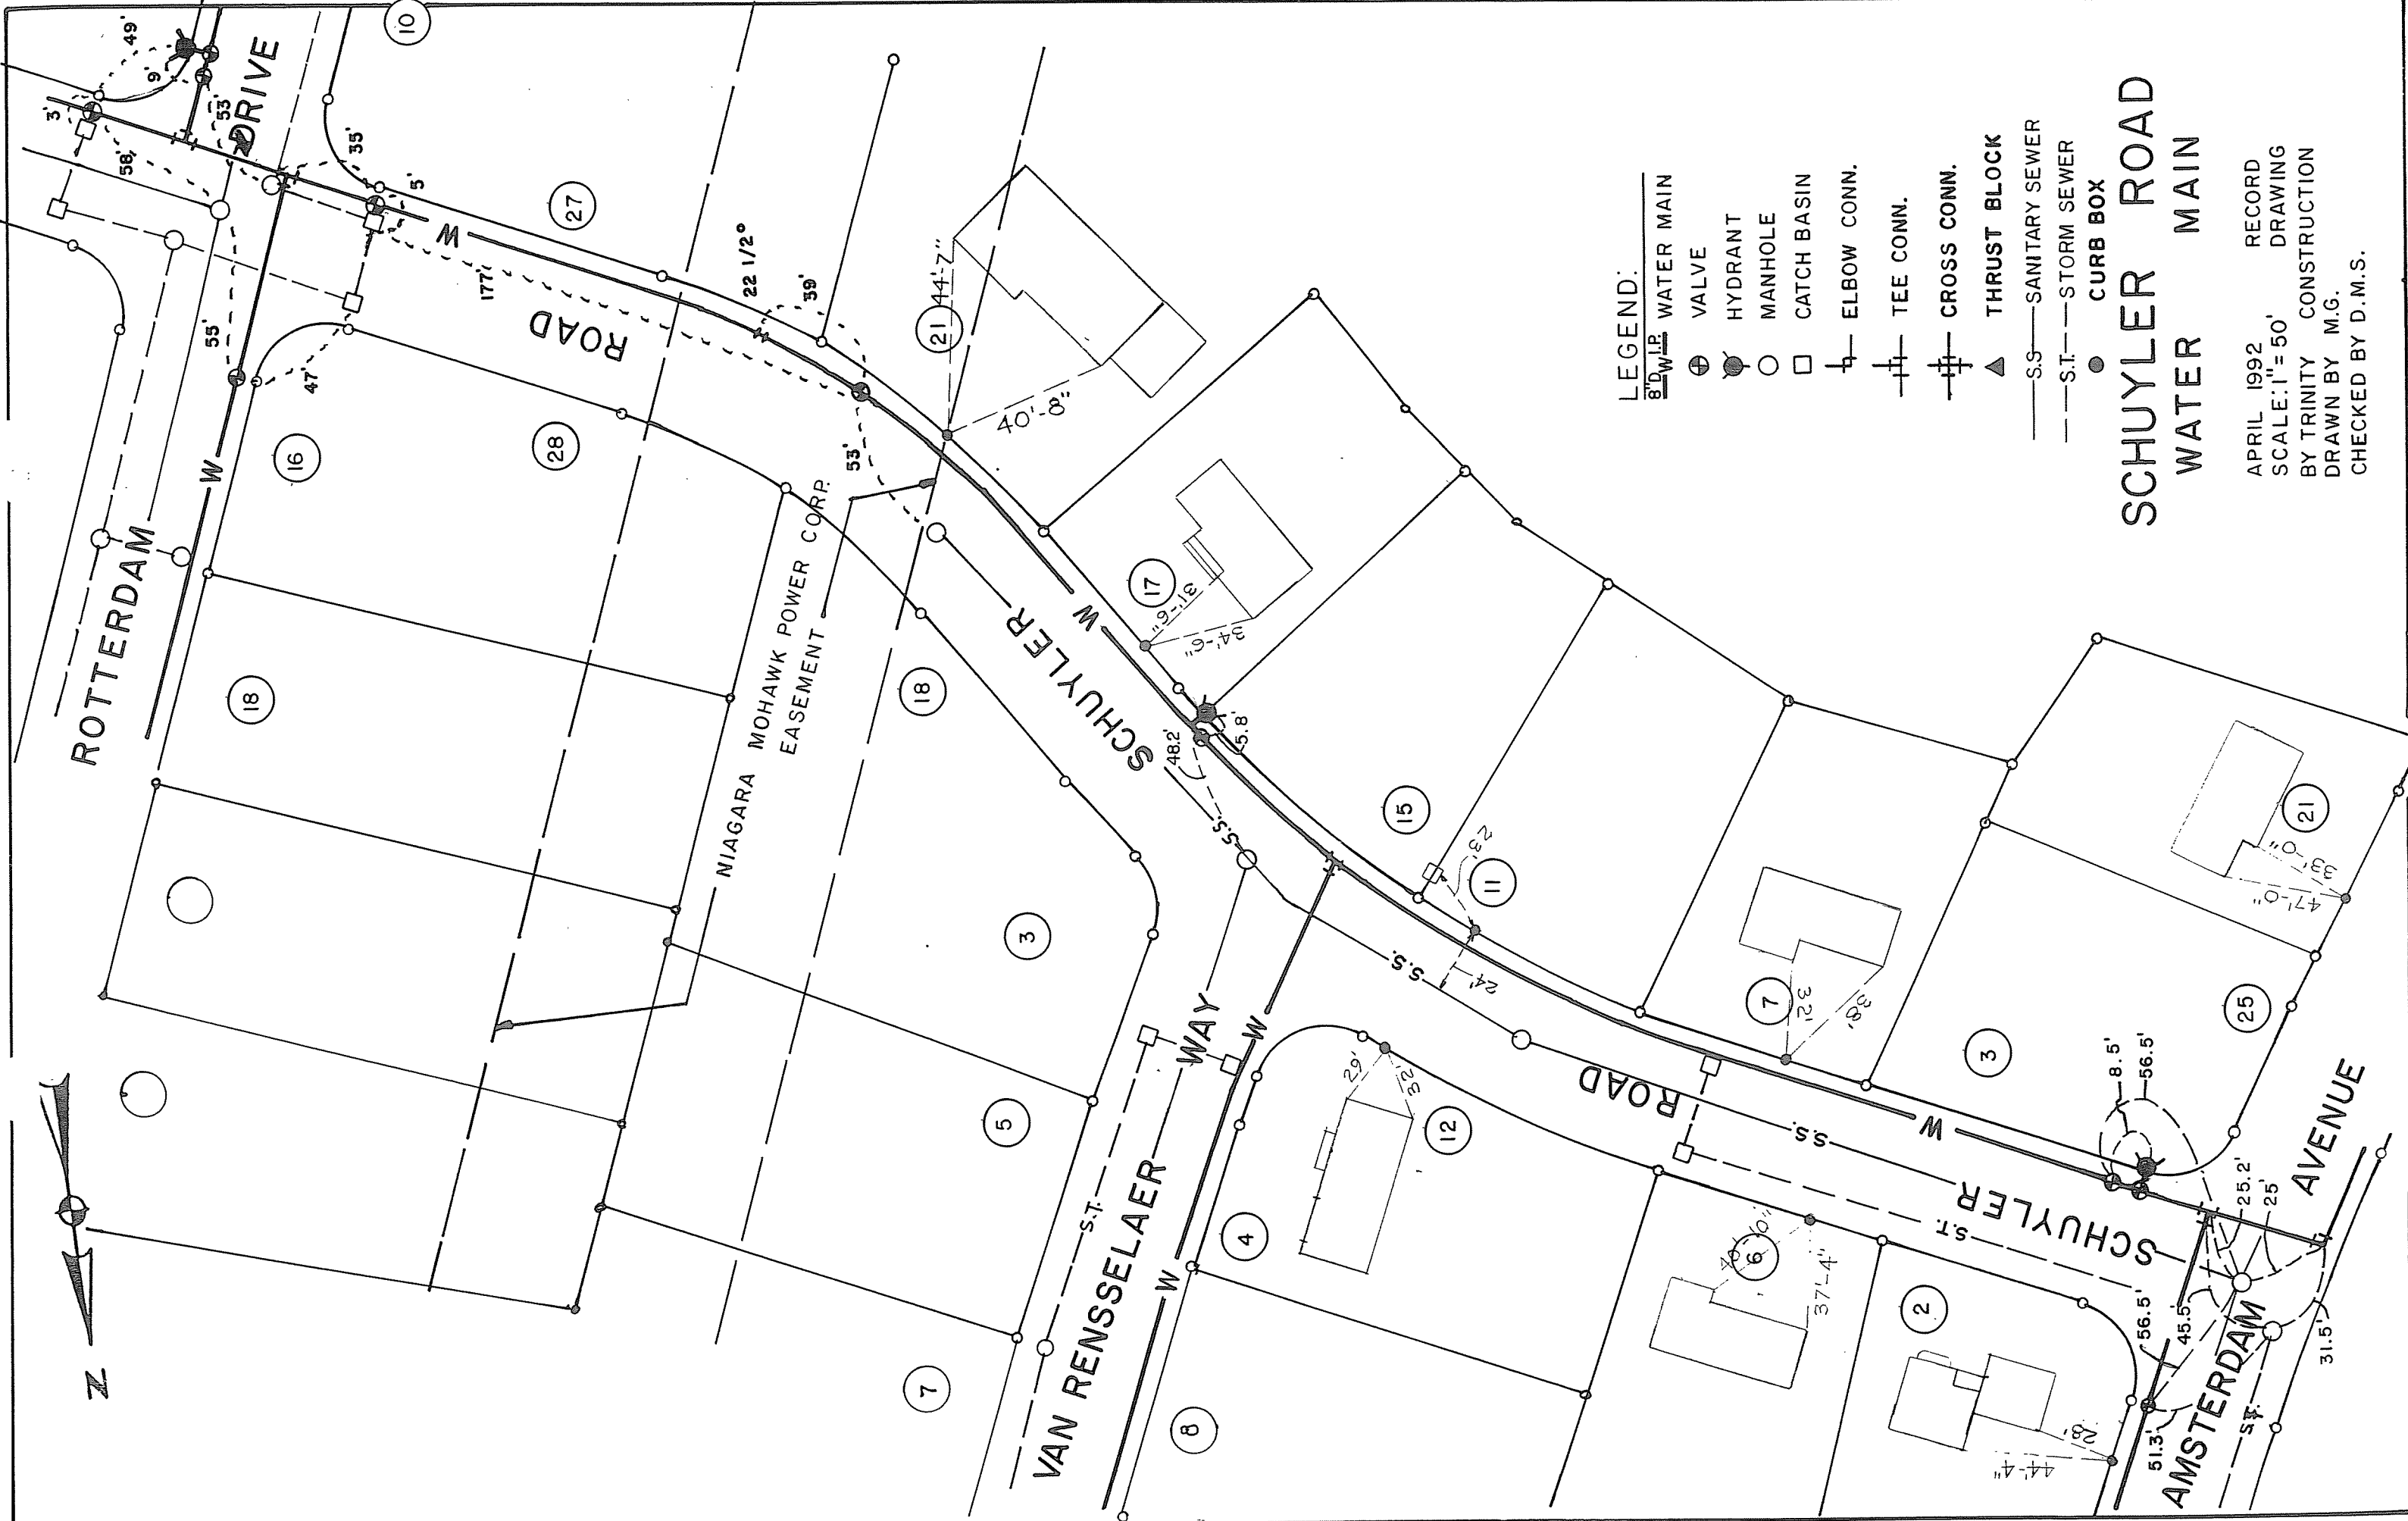

LEGEND:

- | | |
|-------------|----------------|
| 8" D.W.I.P. | WATER MAIN |
| ⊕ | VALVE |
| ⊙ | HYDRANT |
| ○ | MANHOLE |
| □ | CATCH BASIN |
| └┐ | ELBOW CONN. |
| ├┤ | TEE CONN. |
| ┼┼ | CROSS CONN. |
| ▲ | THRUST BLOCK |
| — S.S. — | SANITARY SEWER |
| — S.T. — | STORM SEWER |
| ● | CURB BOX |

SCHUYLER ROAD
WATER MAIN

APRIL 1992 RECORD
SCALE: 1" = 50' DRAWING
BY TRINITY CONSTRUCTION
DRAWN BY M.G.
CHECKED BY D.M.S.