


LEGEND

- CATCH BASIN
- MANHOLE
- ⊙ HYDRANT
- ⊕ GATE VALVE
- ⊥ TEE
- ▲ THRUST BLOCK
- W— WATER MAIN

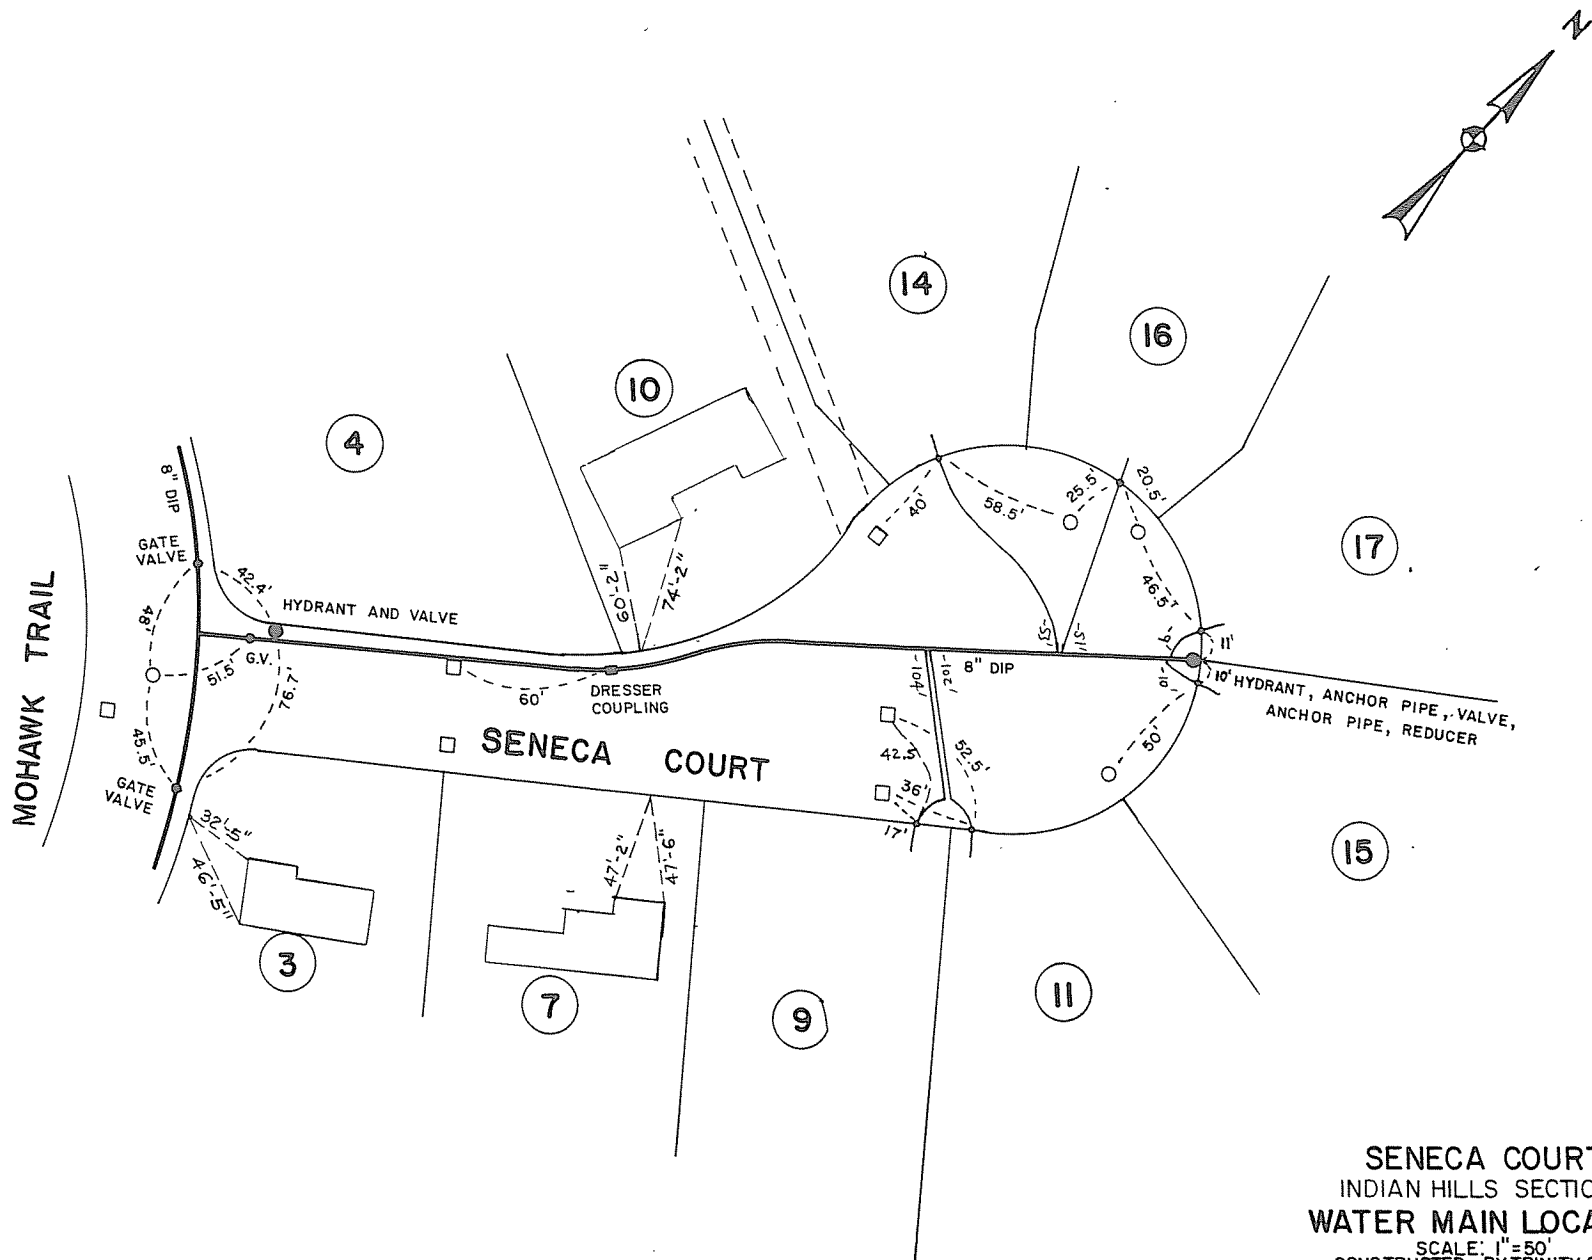

SENECA COURT
INDIAN HILLS SECTION 2
WATER MAIN LOCATION

SCALE: 1"=50'
CONSTRUCTED BY TRINITY CONST.
INSPECTED BY T.O.B.
AUG 1992