


LEGEND

- CATCH BASIN
- MANHOLE
- HYDRANT
- GATE VALVE
- TEE
- ▲ THRUST BLOCK
- W WATER MAIN

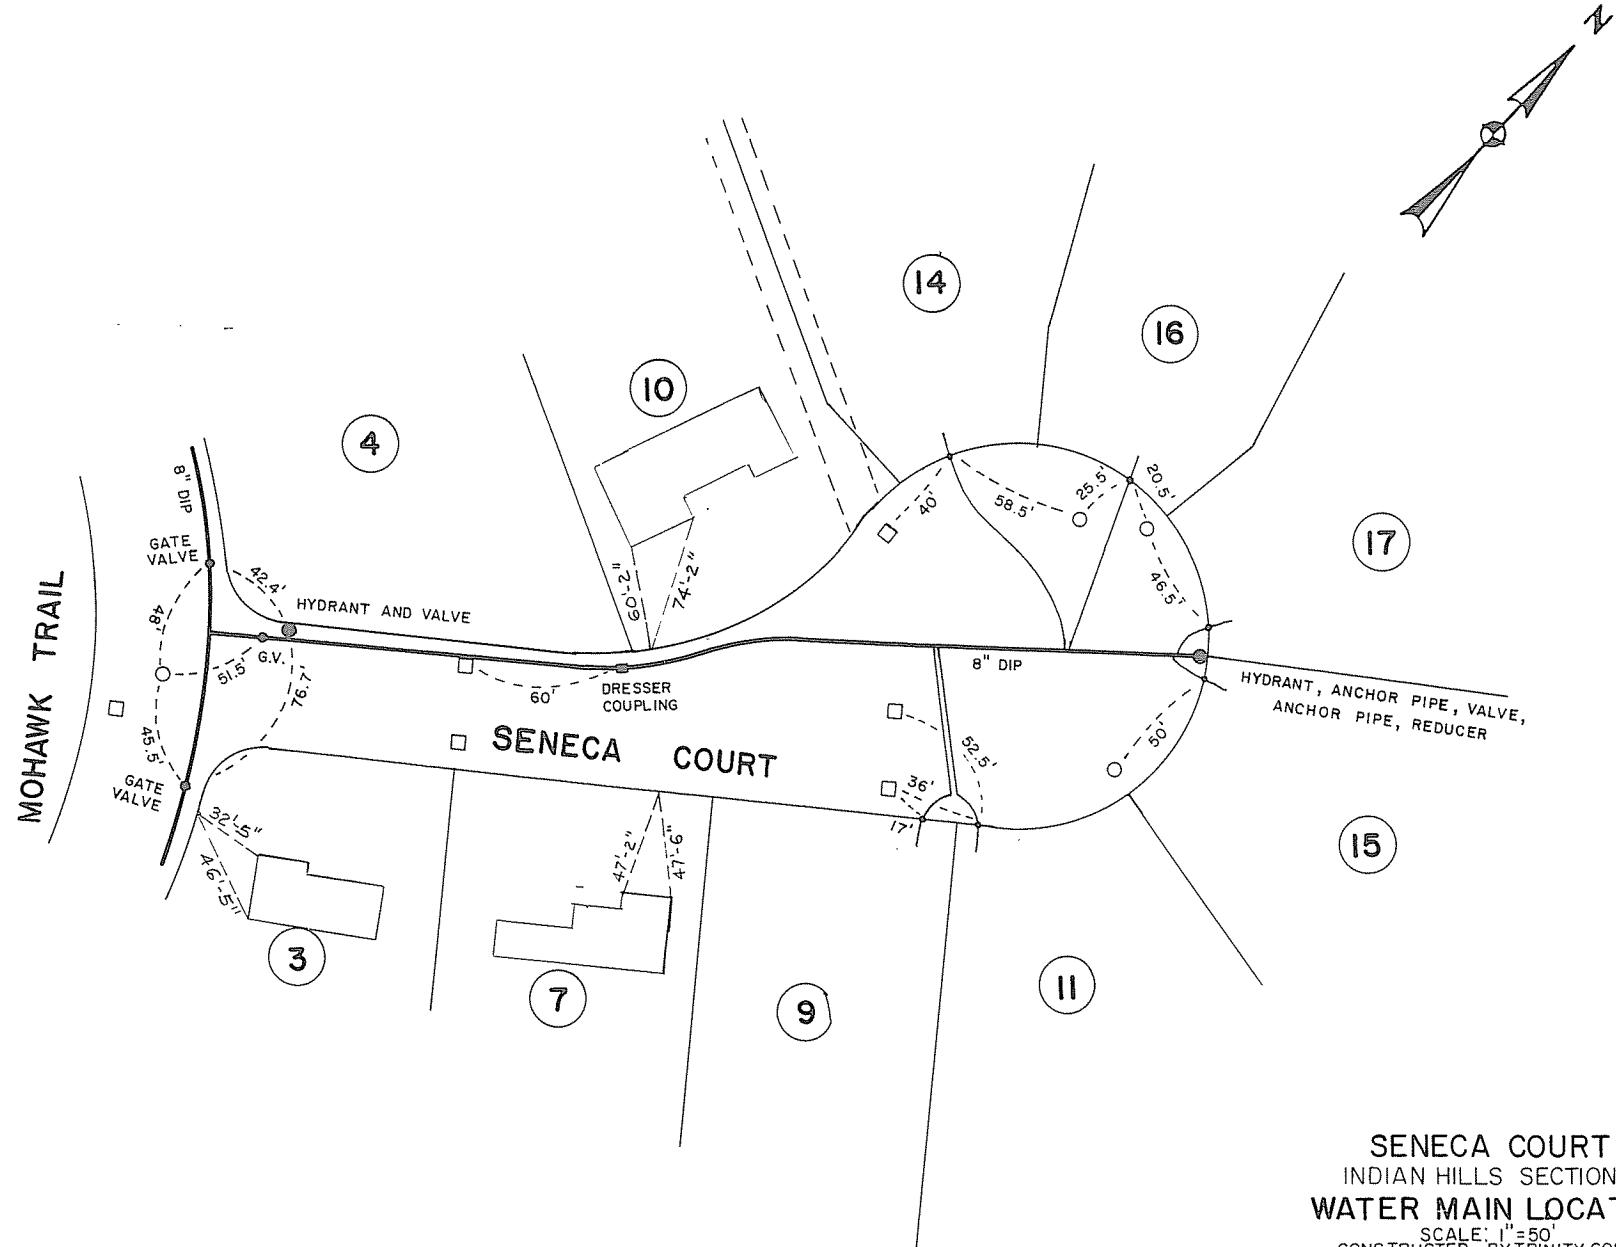

SENECA COURT
INDIAN HILLS SECTION 2
WATER MAIN LOCATION
SCALE: 1" = 50'
CONSTRUCTED BY TRINITY CONST.
INSPECTED BY T.O.B.
AUG. 1992