


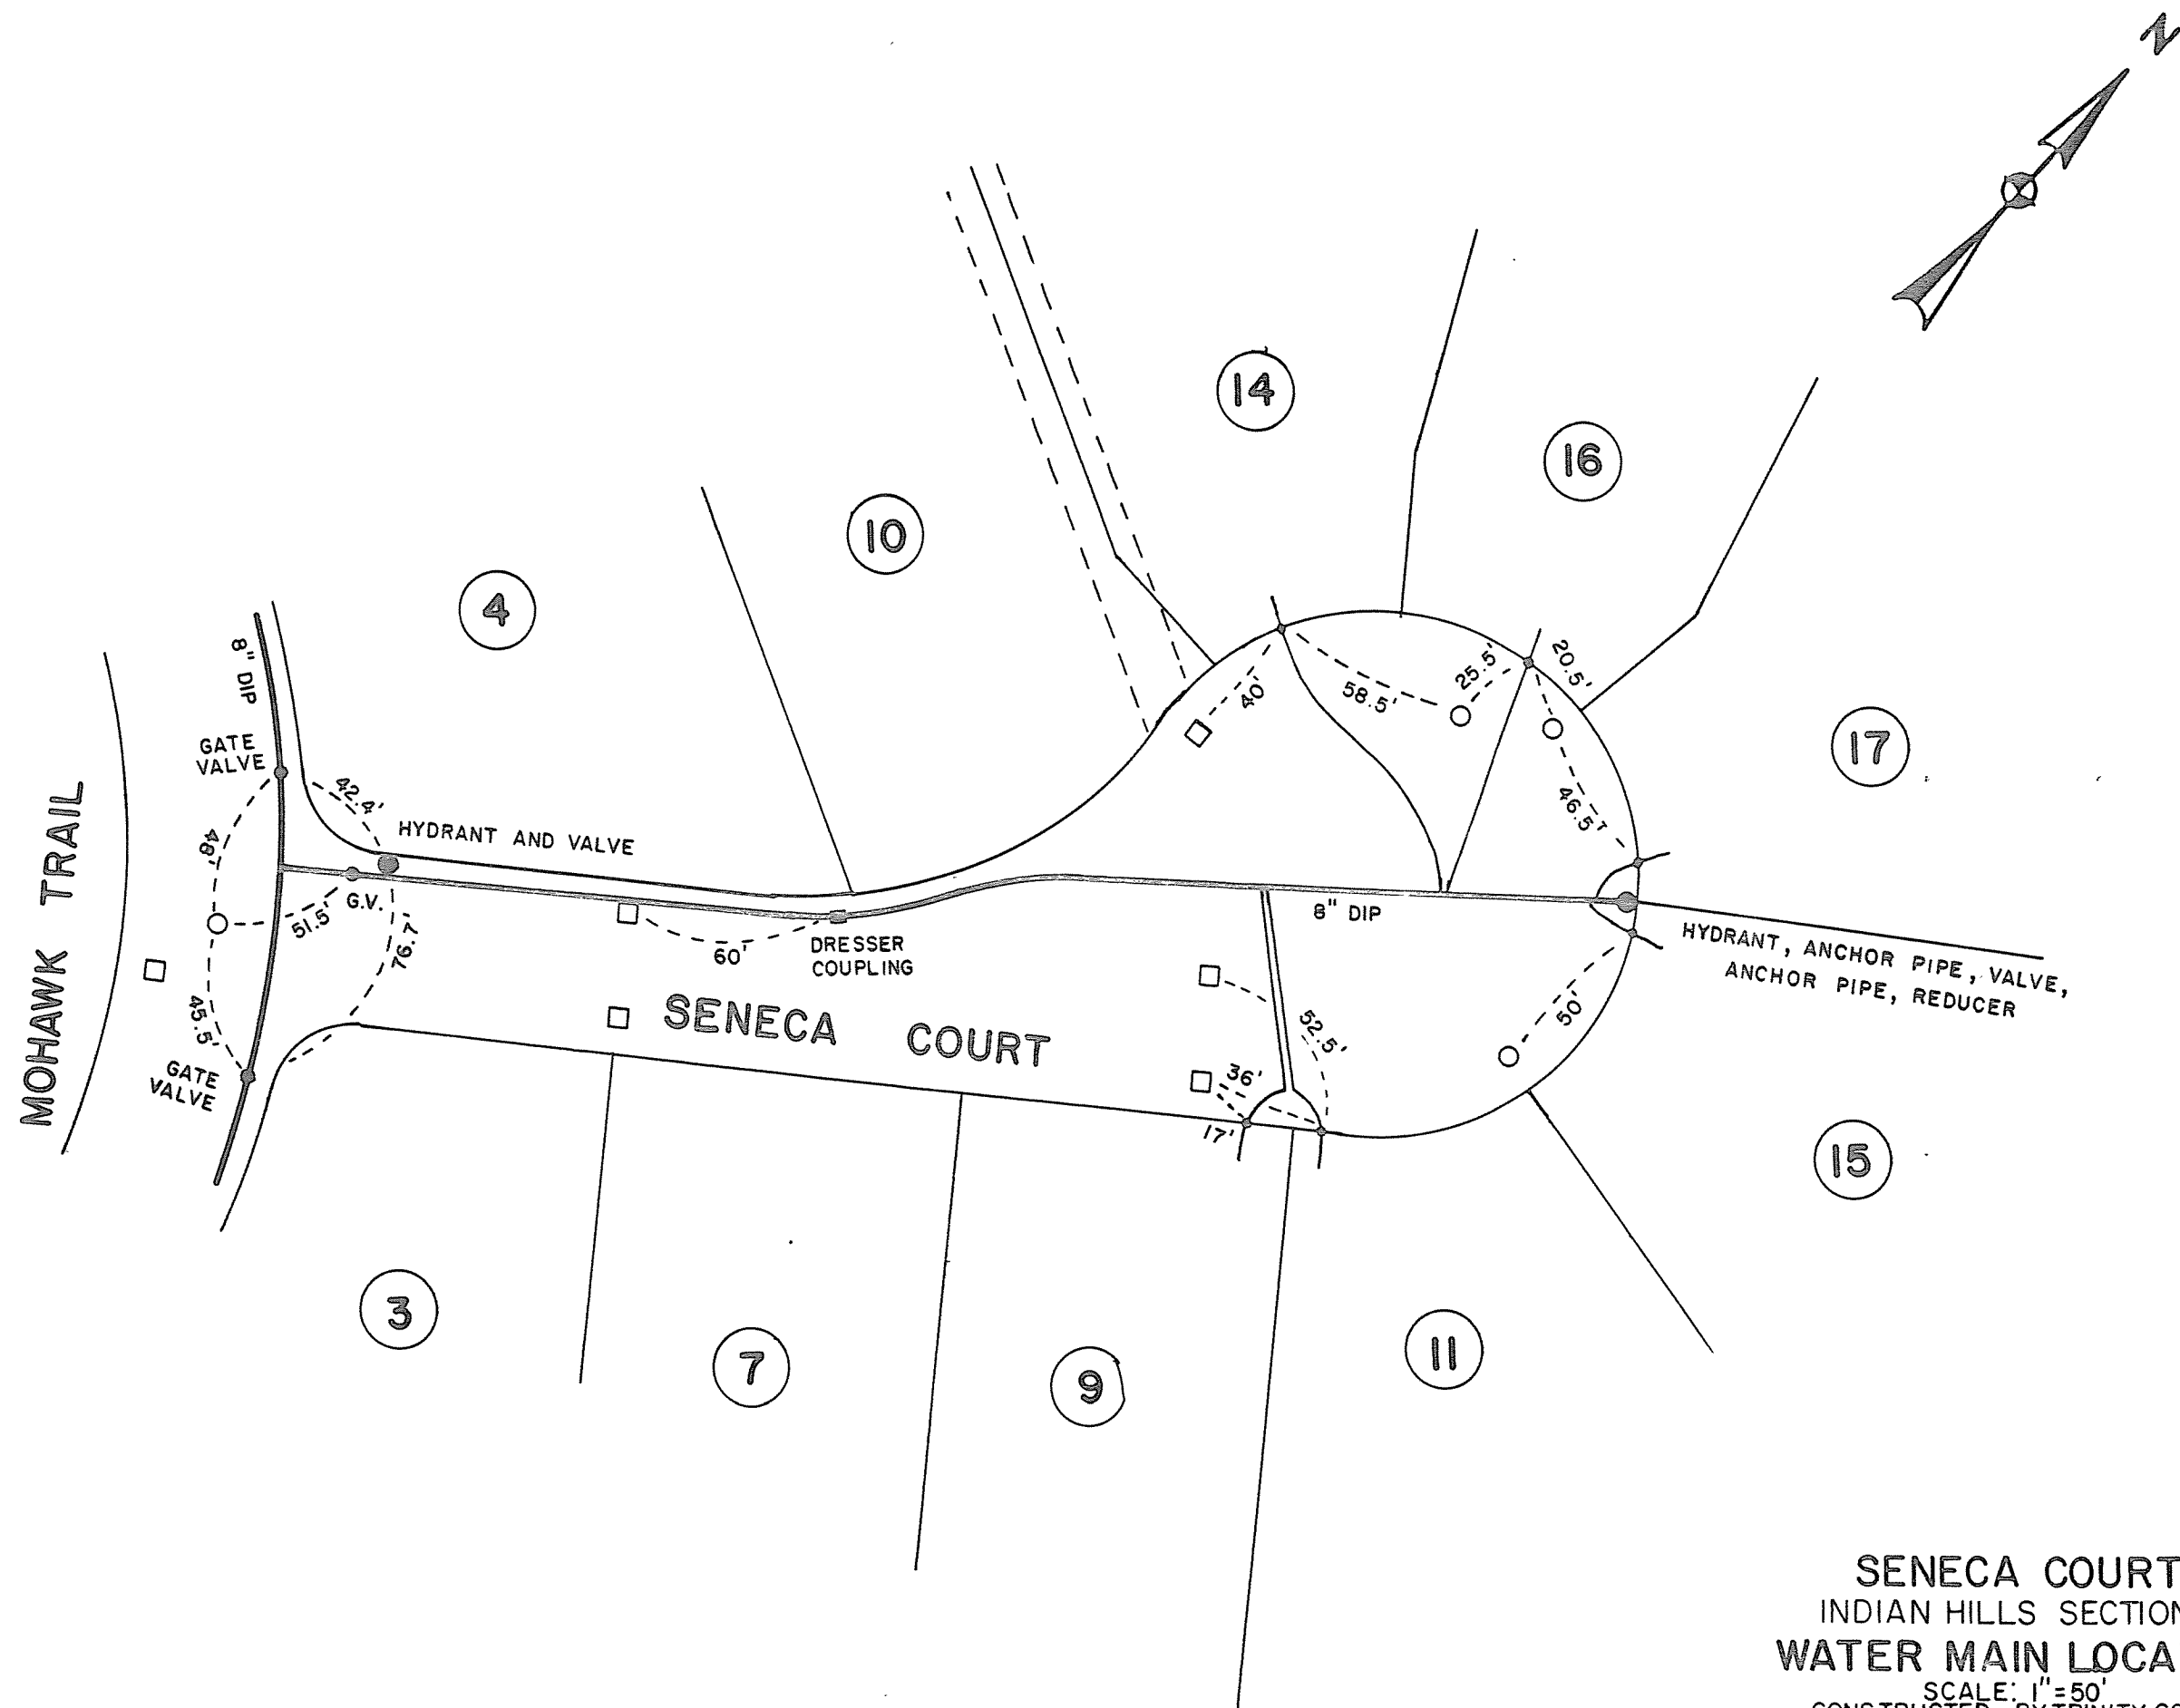

SENECA COURT
 INDIAN HILLS SECTION 2
WATER MAIN LOCATION
 SCALE: 1"=50'
 CONSTRUCTED BY TRINITY CONST.
 INSPECTED BY T.O.B.
 AUG. 1992