
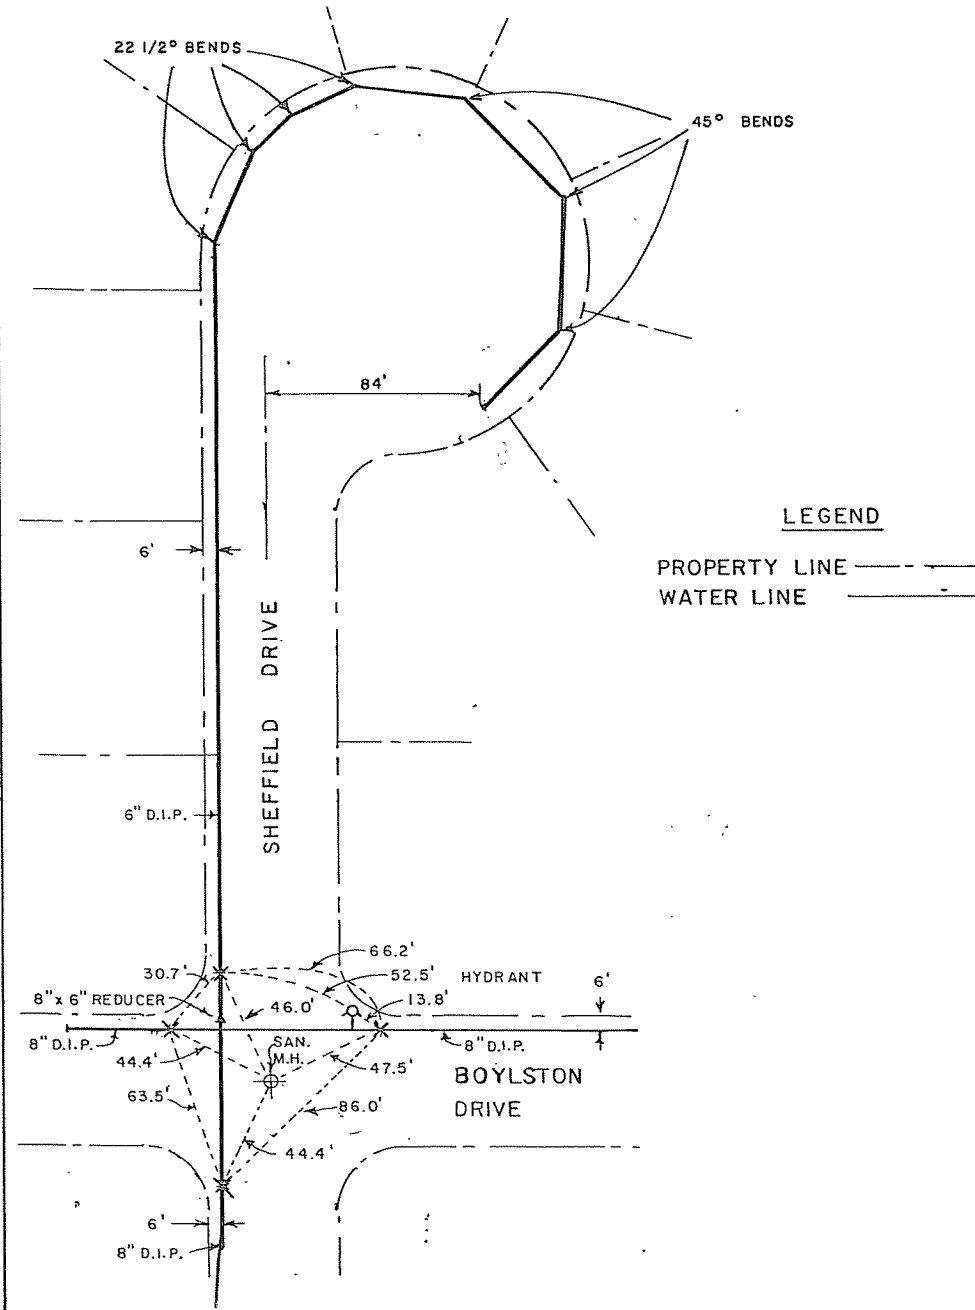


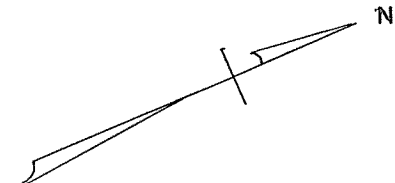

LEGEND

PROPERTY LINE - - - - -
WATER LINE - - - - -

SHEFFIELD DRIVE
LAURA-LANA

BOYLSTON DRIVE
SHEFFIELD DRIVE
WATER DISTRICT NO. 1
TOWN OF BETHLEHEM
RECORD OF INSTALLATIONS
J. KENNETH FRASER & ASSOCIATES, P.C.
CONSULTING ENGRS. RENSSELAER, N.Y.
SCALE 1" = 50' SEPTEMBER 1977